

WALTHALL
E129
10-16-73

MISSISSIPPI
 BOARD OF WATER COMMISSIONERS
 416 North State Street
 Jackson, Mississippi 39201

CODED

WATER WELL DRILLERS LOG

10-16 19 73 *F. J. ...* *Walthall*
 date well completed firm name county well located

LANDOWNER:

Carroll Smith
R.R. ...
 (mailing address)

description of formations encountered

from to

Red clay 0 20
Red gravel 20 120
Coarse sand & gravel 120 133

WELL LOCATION:

sec. *34* T. *2* N. R. *10* E
3 miles *W* of *...*
 (distance) (direction) (nearest town)

WELL PURPOSE:

Home
 (home, irrigation, municipal, industrial)

WELL COMPLETION DATA:

- (1) diameter (inches) *4*
- (2) total depth (feet) *133*
- (3) static water level (feet) *90* below above top of ground.
- (4) casing *plastic*, *125*,
 (material) (depth)
4 if telescope see back.
 (size)
- (5) screen *8*, *125*
 (length) (depth to top)
4, *plastic*
 (size) (material)
- (6) pump *1HP*, *31*
 (HP) (yield gpm)
elec
 (type power)
- (7) electric log *No*
 (yes or no)
 (organization running log)
- (8) how well bottom plugged *covered*


CODED

DRILLERS REMARKS:

NOV 15 1973

If well telescopes please
sketch and show depths.

GROUND LEVEL

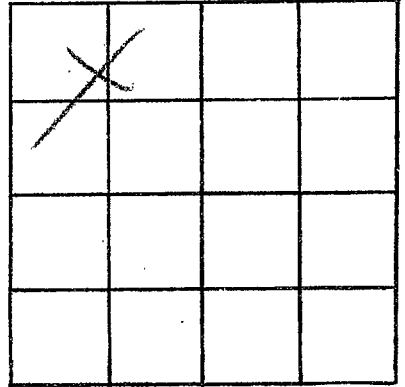

SECTION 34

Please indicate well location X.

ADDITIONAL INFORMATION

If more than one screen,
show locations of each on sketch.