

WALTHALL  
E/30  
8/73

MISSISSIPPI  
BOARD OF WATER COMMISSIONERS  
416 North State Street  
Jackson, Mississippi 39201

CODED

WATER WELL DRILLERS LOG

Aug. 1973 E. B. Sherrard, Walthall  
date well completed firm name county well located

LANDOWNER:

Casey P. Quinn

description of formations encountered

from to

Rt. 4 - Jopiertown, Miss.  
(mailing address)

B.F.D SANDY  
CLAY GR.  
GR. SAND

0 50'  
50' 102'

WELL LOCATION:

sec. 5 T20N R10E  
S  
5 miles NW of Jopiertown  
(distance) (direction) (nearest town)

WELL PURPOSE:

(home, irrigation, municipal, industrial)

WELL COMPLETION DATA:

- (1) diameter (inches) 2"
- (2) total depth (feet) 102'
- (3) static water level (feet) 60 <sup>below</sup>/<sub>above</sub> top of ground.
- (4) casing pl. 97'  
(material) (depth)  
2" If telescope see back.  
(size)
- (5) screen 5'  
(length) (depth to top)  
2" pl.  
(size) (material)
- (6) pump 1 8  
(HP) (yield gpm)  
E  
(type power)
- (7) electric log (yes or no)

(organization running log)

(8) how well bottom plugged BWV


CODED

DRILLERS REMARKS:

REC-111  
FEB 9 1974  
MISS. Bd. of Water Comm.

If well telescopes please sketch and show depths.

GROUND LEVEL

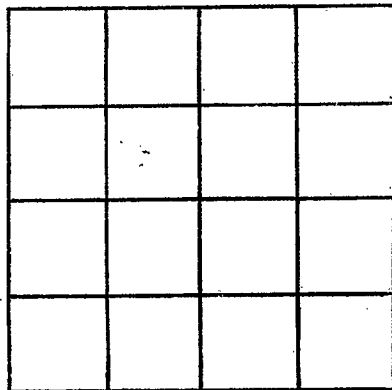

SECTION \_\_\_\_\_

Please indicate well location X.

ADDITIONAL INFORMATION

A series of horizontal lines for recording additional information, starting below the 'ADDITIONAL INFORMATION' header and extending to the bottom of the page.

If more than one screen, show locations of each on sketch.