

WALTHALL  
E 135  
10/11/74

MISSISSIPPI  
BOARD OF WATER COMMISSIONERS  
416 North State Street  
Jackson, Mississippi 39201

CODED

WATER WELL DRILLERS LOG

Oct 11 1974 date well completed  
Chester Renee firm name  
Walthall county well located

LANDOWNER: Stanley Bumfield	description of formations encountered	from	to
RFD Tylertown (mailing address)	clay	0	15
WELL LOCATION: sec. 24 T. 2 N. R. 9 E	sand & gravel	15	28
7 miles W of Tylertown (distance) (direction) (nearest town)	Bluechick	28	46
WELL PURPOSE: house (home, irrigation, municipal, industrial)	coarse sand	46	126
WELL COMPLETION DATA:			
(1) diameter (inches) 4"			
(2) total depth (feet) 120			
(3) static water level (feet) 3 below top of ground.			
(4) casing <u>plastic</u> <u>bottom</u> (material) (depth)			
(size) If telescope see back.			
(5) screen 6' 120 (length) (depth to top)			
(size) <u>1/2"</u> <u>plastic</u> (material)			
(6) pump <u>summers old pump</u> (HP) (yield gpm)			
(type power)			
(7) electric log <u>no</u> (yes or no)			
(organization running log)			
(8) how well bottom plugged <u>wood plug</u>			
DRILLERS REMARKS: <u>old 2" well plugged</u>			


RECEIVED

NOV 18 1974

MISS. RD. OF WATER COMM

If well telescopes please sketch and show depths.

GROUND LEVEL

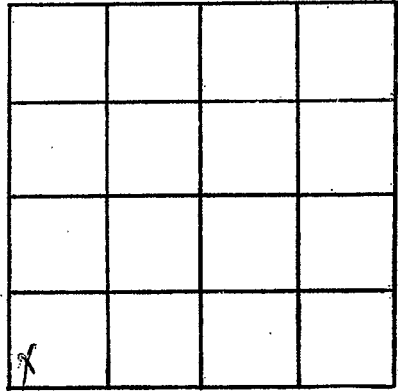

SECTION 24

Please indicate well location X.

ADDITIONAL INFORMATION

If more than one screen,  
show locations of each on sketch.