

E 139  
Walthall  
6-4-75

MISSISSIPPI  
 BOARD OF WATER COMMISSIONERS  
 416 North State Street  
 Jackson, Mississippi 39201

CODED

WATER WELL DRILLERS LOG

6-4 1975 Fitzgerald Well Serv Walthall  
 date well completed firm name county well located

LANDOWNER:	description of formations encountered	from	to
<u>Logan Cornford</u>			
<u>R.R. Lybriam</u> (mailing address)	<u>Red Clay</u>	<u>0</u>	<u>20</u>
	<u>Red Sand</u>	<u>20</u>	<u>130</u>
	<u>Coarse sand &amp; gravel</u>	<u>130</u>	<u>146</u>

WELL LOCATION:  
 sec. 29 T 2 N R. 10 E  
4 miles W of Falston  
 (distance) (direction) (nearest town)

WELL PURPOSE: Home  
 (home, irrigation, municipal, industrial)


- WELL COMPLETION DATA:
- (1) diameter (inches) 4
  - (2) total depth (feet) 146
  - (3) static water level (feet) 100 below top of ground.
  - (4) casing plastic, 138,  
 (material) (depth)  
4 if telescope see back.  
 (size)
  - (5) screen 8, 138  
 (length) (depth to top)  
4, plastic  
 (size) (material)
  - (6) pump 1/2, 10  
 (HP) (yield. gpm)  
elec  
 (type power)
  - (7) electric log Yes  
 (yes or no)  
 (organization running log)
  - (8) how well bottom plugged Sealed

DRILLERS REMARKS:

RECEIVED  
 JUN 10 1975  
 MISS. Bd. OF WATER COMM.

If well telescopes please  
sketch and show depths.

GROUND LEVEL

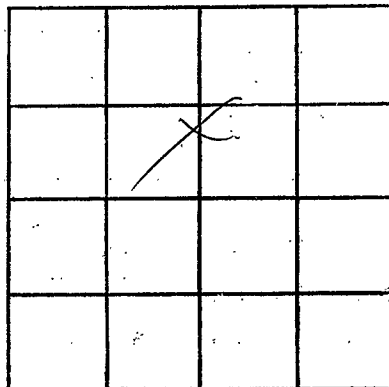

SECTION 29

Please indicate well location X.

ADDITIONAL INFORMATION

If more than one screen,  
show locations of each on sketch.