

Walthall
 E 140
 7-2-75

MISSISSIPPI
 BOARD OF WATER COMMISSIONERS
 416 North State Street
 Jackson, Mississippi 39201


CODED

WATER WELL DRILLERS LOG

7-2
 date well completed


1975 *Fitzgerald*
 firm name

Walthall
 county well located

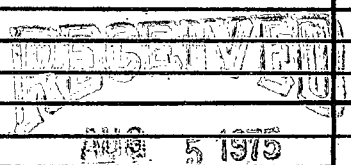LANDOWNER:	description of formations encountered	from	to
<i>Aselle Jones</i> <i>RR 1</i> (mailing address)			
WELL LOCATION:			
sec. <i>4</i> T. <i>2</i> N. R. <i>10</i> E. <i>134</i> S. W.			
<i>5</i> miles <i>NW</i> of <i>Fitz</i> (distance) (direction) (nearest town)			
WELL PURPOSE: <i>Home</i> (home, irrigation, municipal, industrial)			
WELL COMPLETION DATA:			
(1) diameter (inches) <i>4</i>			
(2) total depth (feet) <i>124</i>			
(3) static water level (feet) <i>94</i> below above top of ground.			
(4) casing <i>Plastic</i> <i>116</i> (material) (depth)			
<i>4</i> if telescope see back. (size)			
(5) screen <i>8</i> <i>116</i> (length) (depth to top)			
<i>4</i> <i>Plastic</i> (size) (material)			
(6) pump <i>1/2</i> <i>20</i> (HP) (yield gpm)			
<i>also</i> (type power)			
(7) electric log <i>no</i> (yes or no)			
(organization running log)			
(8) how well bottom plugged <i>Sand filter</i>			
DRILLERS REMARKS:			
 AUG 5 1975			
MISS. DEP. OF WATER RESOURCES MISS. DEP. OF PUBLIC SAFETY			

If well telescopes please sketch and show depths.

GROUND LEVEL

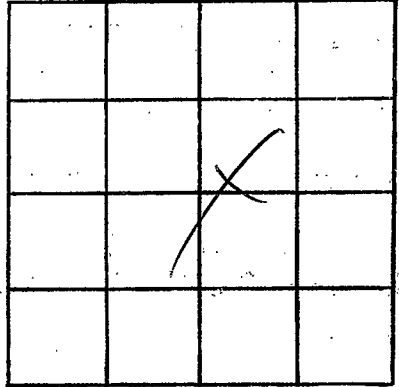

SECTION 4

Please indicate well location X.

ADDITIONAL INFORMATION

If more than one screen, show locations of each on sketch.