

Walthall
E 141
8-26-75

MISSISSIPPI
 BOARD OF WATER COMMISSIONERS
 416 North State Street
 Jackson, Mississippi 39201

WATER WELL DRILLERS LOG

CODED
 Walthall


8-26
 date well completed

1975 Fitzgould Well Serv
 firm name

county well located

LANDOWNER:	description of formations encountered	from	to
<u>Evon Hawley</u>			
<u>R.R. Fylectown</u> (mailing address)	<u>Red clay</u>	<u>0</u>	<u>20</u>
	<u>Red sand & gravel</u>	<u>20</u>	<u>105</u>
	<u>Coarse sand & gravel</u>	<u>105</u>	<u>128</u>
WELL LOCATION:			
sec. <u>11</u> T. <u>2</u> (N) (S) R. <u>10</u> (E) (W)			
<u>2</u> miles <u>N</u> of <u>Fylectown</u> (distance) (direction) (nearest town)			
WELL PURPOSE: <u>Home</u> (home, irrigation, municipal, industrial)			
WELL COMPLETION DATA:			
(1) diameter (inches) <u>4</u>			
(2) total depth (feet) <u>128</u>			
(3) static water level (feet) <u>55</u> below above-top of ground.			
(4) casing <u>plastic</u> , <u>120</u> , (material) (depth)			
<u>4</u> if telescope see back. (size)			
(5) screen <u>8</u> , <u>120</u> (length) (depth to top)			
<u>4</u> , <u>plastic</u> (size) (material)			
(6) pump <u>1/2</u> , <u>10</u> (HP) (yield gpm)			
<u>Elie</u> (type power)			
(7) electric log <u>no</u> (yes or no)			
(organization running log)			
(8) how well bottom plugged <u>Sand block</u>			
DRILLERS REMARKS:			

CODED

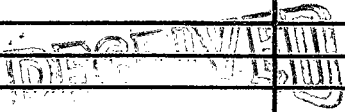


UCT 10 1975

MISSISSIPPI BOARD OF WATER COMMISSIONERS

If well telescopes please sketch and show depths.

GROUND LEVEL

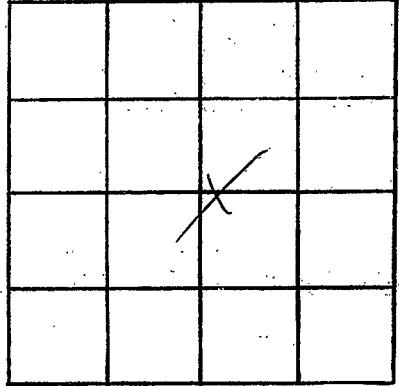

SECTION 11

Please indicate well location X.

ADDITIONAL INFORMATION

If more than one screen, show locations of each on sketch.