

Walthall
E 142
8-27-75

MISSISSIPPI
 BOARD OF WATER COMMISSIONERS
 416 North State Street
 Jackson, Mississippi 39201

CODED

WATER WELL DRILLERS LOG

8-27
 date well completed

19 75

Fitzgibbon Law
 firm name

Walthall
 county well located

LANDOWNER:	description of formations encountered	from	to
<u>J. B. Hope</u>	<u>Red clay</u>	<u>0</u>	<u>20</u>
<u>R.R. Eubank</u> (mailing address)	<u>Red gravel</u>	<u>20</u>	<u>80</u>
	<u>Red sand</u>	<u>80</u>	<u>100</u>
	<u>Coarse sand & gravel</u>	<u>100</u>	<u>135</u>
WELL LOCATION: sec. <u>16</u> T. <u>2</u> N. R. <u>10</u> E. <u>S</u> <u>W</u> <u>5</u> miles <u>W</u> of <u>Ft. Lauderdale</u> (distance) (direction) (nearest town)			
WELL PURPOSE: (home, irrigation, municipal, industrial)			
WELL COMPLETION DATA:			
(1) diameter (inches) <u>4</u>			
(2) total depth (feet) <u>135</u>			
(3) static water level (feet) <u>100</u> below top of ground.			
(4) casing <u>plastic</u> , <u>127</u> , (material) (depth) <u>f</u> If telescope see back. (size)			
(5) screen <u>8</u> , <u>127</u> (length) (depth to top)			
(6) pump <u>1/2</u> , <u>plastic</u> (HP) (material)			
(6) pump <u>1/2</u> , <u>10</u> (HP) (yield gpm)			
(7) electric log <u>no</u> (yes or no)			
(7) electric log <u>no</u> (organization running log)			
(8) how well bottom plugged, <u>sand block</u>			
DRILLERS REMARKS:			

CODED


MISSISSIPPI BOARD OF WATER COMMISSIONERS

OCT 10 1975

MISS. RD. OF WATER COMMISSIONERS

If well telescopes please sketch and show depths.

GROUND LEVEL

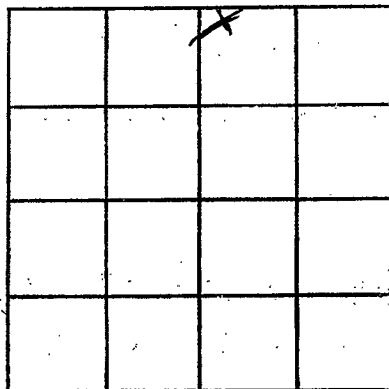

SECTION 16

Please indicate well location X.

ADDITIONAL INFORMATION

If more than one screen, show locations of each on sketch.