

Walthall
E 143
8-28-75

MISSISSIPPI
BOARD OF WATER COMMISSIONERS
416 North State Street
Jackson, Mississippi 39201

CODED

WATER WELL DRILLERS LOG

8-28
date well completed

19 75 *F. Gumbel & Son*
firm name


Walthall
county well located

LANDOWNER:	description of formations encountered	from	to
<i>Alberta Jacobs</i>			
<i>R.B. Gylton</i> (mailing address)	<i>Red clay</i> <i>Red sand</i> <i>Coarse sand & gravel</i>	<i>0</i> <i>20</i> <i>100</i>	<i>20</i> <i>100</i> <i>117</i>
WELL LOCATION:			
sec. <i>4</i> T. <i>2N</i> R. <i>14E</i> <i>6</i> miles <i>NW</i> of <i>Gylton</i> (distance) (direction) (nearest town)			
WELL PURPOSE: <i>Home</i> (home, irrigation, municipal, industrial)			
WELL COMPLETION DATA:			
(1) diameter (inches) <i>4</i>			
(2) total depth (feet) <i>117</i>			
(3) static water level (feet) <i>80</i> below above top of ground.			
(4) casing <i>plastic</i> , <i>109</i> , (material) (depth) <i>4</i> if telescope see back. (size)			
(5) screen <i>8</i> , <i>109</i> (length) (depth to top)			
(6) pump <i>1/2</i> , <i>10</i> (HP) (yield gpm) <i>elec</i> (type power)			
(7) electric log <i>no</i> (yes or no)			
(organization running log)			
(8) how well bottom plugged <i>sand filter</i>			
DRILLERS REMARKS:			

OCT 16 1975
MISS. Bd. OF WATER COMMISSIONERS

If well telescopes please sketch and show depths.

GROUND LEVEL

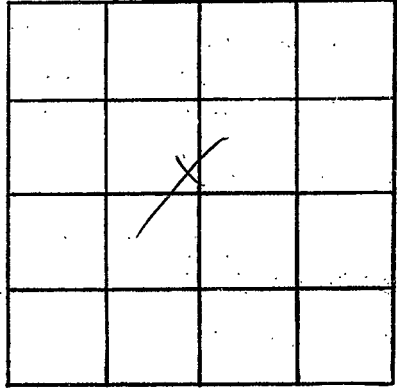

SECTION 4

Please indicate well location X.

ADDITIONAL INFORMATION

If more than one screen, show locations of each on sketch.