

MISSISSIPPI DEPARTMENT OF NATURAL RESOURCES

Bureau of Land and Water Resources

Southport Mall

P.O. Box 10631

CODED

Jackson, Mississippi 39209

WATER WELL DRILLERS LOG

E 151
 Walthall Co.
 1-26-84

Walthall Co.
 Walthall

1-26 1984 Rayhorn Drilling & Const. Co. Walthall Co.
 date well completed firm name county well located

LANDOWNER:	description of formations encountered	from	to
B. G. Fortenberry Drill Co. Natchez, Miss. (mailing address)			
WELL LOCATION: sec. 16 T-2N S R-10E W 15 miles SW of Brookhaven (distance) (direction) (nearest town)	Sand	21	70
WELL PURPOSE: oil field (home, irrigation, municipal, industrial)	Rock CODED	71	76
WELL COMPLETION DATA: (1) diameter (inches) 3"	Sand	77	100
(2) total depth (feet) 300'	Blue Chalk	101	270
(3) static water level (feet) 70' below top of ground.	Sand	271	300
(4) casing PVC, 280' (material) (depth) 3" (size) if telescope see back.	No. 1 Board of Ed. Educational 16-10 #1 2310' N + 2308' W of SEC 10 SEC 16-2N-10E		
(5) screen 20' (length), 280' (depth to top) 3" (size), Stalled Pipe (material)			
(6) pump (HP) 52.6 gm (yield gpm) (type power)			
(7) electric log no (yes or no) (organization running log)			
(8) how well bottom plugged Wood Plug			

DEPT. OF NATURAL RESOURCES
 BUREAU OF LAND & WATER RESOURCES


APR 12 1984

RECEIVED

DRILLERS REMARKS:

If well telescopes please sketch and show depths.

GROUND LEVEL

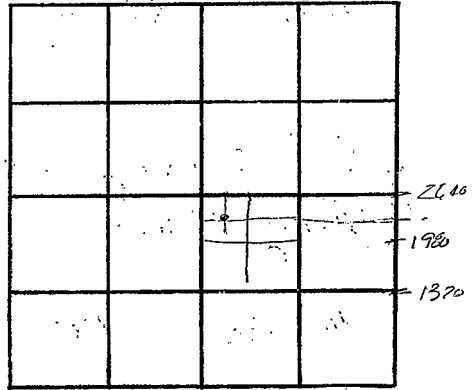

SECTION _____

Please indicate well location X.

ADDITIONAL INFORMATION

If more than one screen, show locations of each on sketch.