

MISSISSIPPI DEPARTMENT OF NATURAL RESOURCES

Bureau of Land and Water Resources

Southport Mall

P.O. Box 10631

Jackson, Mississippi 39209

WATER WELL DRILLERS LOG

CODED

WALTHALL

E152

March 12
date well completed

1984 Reuss Well Co.
firm name

Walthall
county well located

LANDOWNER:	description of formations encountered	from	to
<u>Lerane Payan</u> <u>RT 3 Fayetteville</u> (mailing address)	<u>clay gravel</u> <u>sand-gravel</u> <u>red shell</u>	<u>0</u>	<u>10</u> <u>120</u> <u>120</u>
WELL LOCATION: sec. <u>18</u> T <u>2</u> N R <u>10</u> E <u>6</u> miles <u>N. NW</u> of <u>Fayetteville</u> (distance) (direction) (nearest town)	<u>fine lumpy sand</u> <u>sand & pebbles</u>	<u>120</u> <u>170</u>	<u>170</u> <u>182</u>
WELL PURPOSE: <u>home</u> (home, irrigation, municipal, industrial)			
WELL COMPLETION DATA:			
(1) diameter (inches) <u>4"</u>			
(2) total depth (feet) <u>182</u>			
(3) static water level (feet) <u>70</u> below above top of ground.			
(4) casing <u>plastic bottom</u> (material) (depth)			
(size) If telescope see back.			
(5) screen <u>6'</u> <u>176'</u> (length) (depth to top)			
<u>4 1/2"</u> <u>plastic</u> (size) (material)			
(6) pump <u>1/2</u> <u>10</u> (HP) (yield gpm)			
<u>electric</u> (type power)			
(7) electric log <u>no</u> (yes or no)			
(organization running log)			
(8) how well bottom plugged <u>last wash</u>			
DRILLERS REMARKS: <u></u>			


DEPT. OF NATURAL RESOURCES
BUREAU OF LAND & WATER RESOURCES

JUL - 2 1984

RECEIVED

If well telescopes please sketch and show depths.

GROUND LEVEL

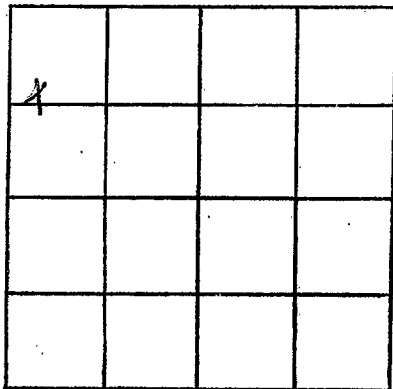

SECTION 18

Please indicate well location X.

ADDITIONAL INFORMATION

If more than one screen,
show locations of each on sketch.