

MISSISSIPPI DEPARTMENT OF NATURAL RESOURCES

Bureau of Land and Water Resources

Southport Mall

P.O. Box 10631

Jackson, Mississippi 39209

WATER WELL DRILLERS LOG

CODED

E15A
WALTHALL
6-21-84

June 21 1984 Plains Miller Walthall
date well completed firm name county well located

LANDOWNER:
Bague Chitto Springs
(Tiger Enterprise)
(mailing address)

description of formations encountered	from	to
<u>black top soil</u>	<u>0</u>	<u>5</u>
<u>sand & gravel</u>	<u>5</u>	<u>30</u>
<u>white chalk</u>	<u>30</u>	<u>80</u>
<u>coarse sand</u>	<u>80</u>	<u>200</u>
<u>sand & fine gravel</u>	<u>200</u>	<u>272</u>

WELL LOCATION:
sec 13 T 2 N R 9 E
6 miles E NE of Julesburg
(distance) (direction) (nearest town)

WELL PURPOSE: water
(home, irrigation, municipal, industrial)

- WELL COMPLETION DATA:
- (1) diameter (inches) 4"
 - (2) total depth (feet) 272
 - (3) static water level (feet) Flow above top of ground (4:09 PM)
 - (4) casing plastic, bottom
(material) (depth)
 - (size) if telescope see back.
 - (5) screen 18" 200'
(length) (depth to top)
 - 4" plastic
(size) (material)
 - (6) pump 1 sub 70'
(HP) (yield gpm)
 - split
(type power)
 - (7) electric log no
(yes or no)
 - (organization running log)
 - (8) how well bottom plugged back well

DRILLERS REMARKS:


DEPT. OF NATURAL RESOURCES
BUREAU OF LAND & WATER RESOURCES

JUL 30 1984

RECEIVED

If well telescopes please sketch and show depths.

GROUND LEVEL

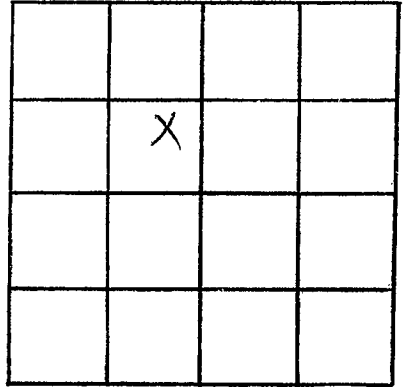

SECTION 13

Please indicate well location X.

ADDITIONAL INFORMATION

If more than one screen,
show locations of each on sketch.