

MISSISSIPPI DEPARTMENT OF NATURAL RESOURCES

Bureau of Land and Water Resources

Southport Mall

P.O. Box 10631

Jackson, Mississippi 39209

WATER WELL DRILLERS LOG

CODED

WALTON
E 157

July 1987 GRINER DRILLING SER. WALTON
date well completed firm name county well located

LANDOWNER: MAGEE'S
CREEK WATER ASSOC.
(MESA WELL)
(mailing address)

description of formations encountered

from to

Top soil	0	3
SAND + GRAVEL	3	160
CLAY	160	208
SAND + GRAVEL (P&A)	208	400

WELL LOCATION: SW 1/4 SW 1/4 NE 1/4
sec. 9 T. 2 N. R. 10 E

miles of (distance) (direction) (nearest town)

WELL PURPOSE: RURAL WATER
(home, irrigation, municipal, industrial)

WELL COMPLETION DATA:

- (1) diameter (inches) 12 3/4
- (2) total depth (feet) 352
- (3) static water level (feet) _____ below above top of ground.
- (4) casing steel, 292 (material), (depth), 12 3/4 (size) if telescope see back.
- (5) screen 50 (length), 302 (depth to top), 8" 304 S.S. (010) (size), (material)
- (6) pump 40 (HP), 500 (yield gpm), Elect (type power)
- (7) electric log YES (yes or no), MOS (organization running log)

(8) how well bottom plugged BACK WASH VALVE + CONCRETE

DRILLERS REMARKS:

CODED


RECEIVED

AUG 21 1987

Department of Natural Resources
Bureau of Land & Water Resources

If well telescopes please
sketch and show depths.

GROUND LEVEL

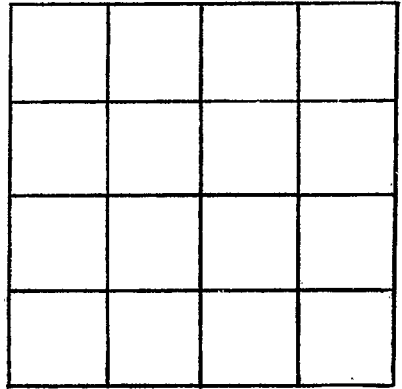

SECTION _____

Please indicate well location X.

ADDITIONAL INFORMATION

If more than one screen,
show locations of each on sketch.