State V	Vell Report	For Office Use Only:		
Part 1 -	Driller's Log			
	nt of Environmental Quality and Water Resources	Aquifer:E226		
PCILLE #: PO	Box 2309	1		
01milit/604	n, MS 39225 )961- 5210	L. S. Elevation:		
Date drilling completed: $11 - 12 - 12$ (601)96	)1- 5228 (fax)	E-log #:		
	cense holder responsible for	the work and filed with the		
State Law requires that this report be prepared by the di Department at the above address within 30 days of com	pletion of drilling of the wel	<i>or borehole.</i> Drehole Location		
Information on Well Owner		$\wedge (n 1) .747$		
(Landowner if borehole is not for a water well)	Latitude: )1.00,76	[" Longitude 040 [] ,742." 44		
Owner Name EVCLYA Staley	Method of Lat/Long (circle o	ne): Conventional Survey,		
Mailing Address: 84 Horseshoe rd	USCS and Hand-held	GPS. Survey-grade OPS		
	1. E. SEV Son 2.0	Twn 2 N Rng 10 F		
Tokotoka: MS 39/0/07	1			
Tylertown, MS 39667 City State Zip Code	Distance Direction	of Tylertown		
Telephone No. (601) \$76-4430	ising			
	ehole Data			
Date drilling started: 1:11.12 Date drilling completed: 11-1	217	Hole diameter: 7 k		
Date drilling started: 1.11.12 Date drilling completed:	Hole deput: 100			
Date drilling started: <u>1.11.16</u> Date drilling completed: <u></u> Location of the source of any surface water used for drilling: <u>/(</u>	Charly Charles			
Method of dosing and volume of Childrane used in unning the				
Logs run (circle all applicable): No log run Electric Gamma Ra	y Density Sonic Neutron	Other:		
Purpose of borehole (check one): Water Well A Geotechnical/Ge		d Source Heat Pump		
Seismic Survey Other (descrite 	be)	lock		
	the state of the s	Other		
Purpose of Well (check one): Home X Industrial Public Supp	lyImgationPisit Cunture	Omor		
If a flowing well, method of flow regulation: Valve Other (describe)				
If a flowing well, method of now regulation. Varte Static Water Level:feet above of below (circle one) land surface Date measured: # 11-12-12				
Static Water Level:				
Well depth: <u>165</u> Well grouted to a depth of <u>10</u> feet Ty	pe of grout (circle one): Neat Ce	ment) Bentonite Mix		
Casing length: 145 feet Casing diameter: 4	inches Type of casing:			
	inches Type of screen:	$\Delta u \Delta$		
Screen length: <u>20</u> feet Screen diameter: <u>4</u>		65feet		
Screen slot size:				
Type of completion (circle all applicable): Gravel packed Und	erreamed Telescoped Ope	л поне планат Бетегорински		
Other (describe):				
Top of lap pipe or reduction in casing:feet. If	telescoped or more than one scr	een, describe on next page		
		Form: OLWR-SWR-1A (04/08		


7

.

## RECEIVED

JAN 1 4 2013

BY: OLWR

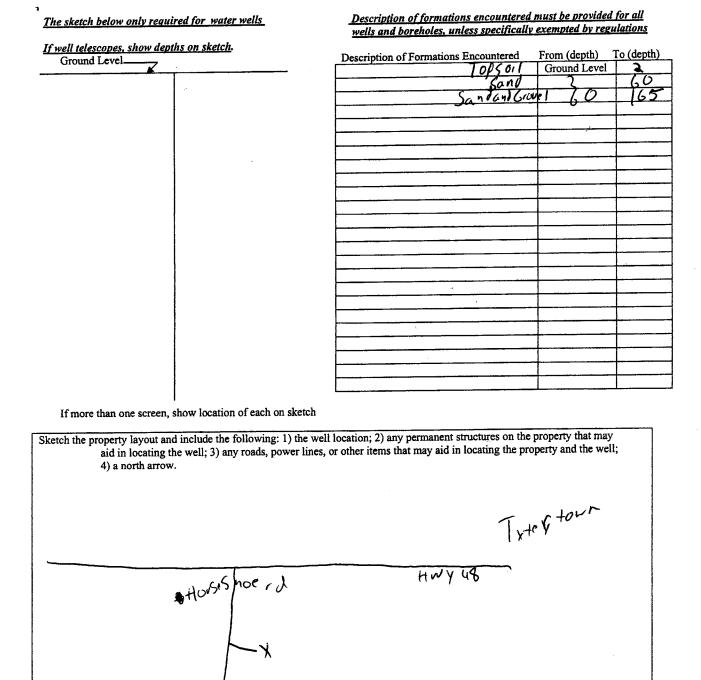

I certify that the well/borehole was drilled, constructed, and completed in accordance with all applicable requirements of the Mississippi Department of Environmental Quality and the Mississippi Department of Health regulations, if applicable, and state

Date

JAMES WELLS 0-586

Landowner Name:

Print Name of Responsible Licensee and License No.

EvelynlStaler

amos Walls

Signature of Licensee

Form: OLWR-SWR-1A (04/08)

RECEIVED

JAN 1 4 2013

BY: OLWR

County: Walthak Permit #: Driller: JAMES WELLS Date completed: 11-12-12 This report should be prepared by the p	Pump Installer's Mississippi Departmen Office of Land a P.O. I Jackson, M (601) (601)35	<b>ELL REPORT</b> art 2 s Completion Report at of Environmental Quality and Water Resources 30x 10631 45 39289-0631 961-5210 4-6938 (fax) iii and filed with the Department	For Office Use Only: Aquifer: Well #: <u>E 2 2 6</u> Elevation: t within 30 days of the
installation of Dilling.		Wall	Location
Well Owner Information Owner Name: Evelyn Experies Mailing Address: <u>84 Horseshoer</u> <u>Tykintown</u> MS City State	Staley_ rd	Latitude: 31°06, 464 Method of Lat/Long (circle on USGS gnad, Hand	Longitude: $090^{\circ}/2.742$ e): Conventional Survey, held GPS, Survey-grade GPS $1_{\text{Twn}} 2N_{\text{Rng}} 10E$ Nearest Town
Telephone No. (661) (76-44)0		<u> </u>	of
Pump Type Circle one Air Lift Jet	Submersible	C Diesel Engine, Gasolin	wer Type frele one ne Engine Natural Gas Tractor PTO
Bucket Piston	Turbine	Electric Motor Hand	
Centrifugal  Rotary    Other (specify):	Flowing Well	Windmill  Other    Horse Power Rating of Motor    Setting Depth:  [0]	(specify): 3/4  4 P )feet
1 <b>N</b>	Gallons Per Minute	Number of Stages:	
Jeau Haus Lover (17.	Below Land Surface	(	easuring Water Level Sincle one asuring Line Steel Tape
Drawdown [(B) – (A)]: $\frac{1}{15}$ Pect I	Below Land Surface Below Land Surface Gallons Per Minute <u>U</u> hours	For flowing well, measured s Well yielded $(4)$ $\underline{S20}$ feet after.	thut in head:feet GPM with a drawdown of hours of pumping
I HEREBY CERTIFY that the above statem <u>JAMES</u> <u>WELLS</u> Print Name of Pump Installer and License N	<u> 2-586</u>	t of my knowledge. CMML Signature of Pump	b Wells

.

RECEIVED
----------

JAN 1 4 2013

BY: OLWR