

STATE WELL REPORT

Part 1

Driller's Log

Mississippi Department of Environmental Quality
Office of Land and Water Resources
P.O. Box 2309
Jackson, MS 39225-2309
(601)961-5210
(601)360-0535 (fax)

For Office Use Only:

Well #: E231
Aquifer: _____
E-Log #: _____

County: Walthall
Permit #: _____
Driller: James M. Wells
Date drilling completed: 11-11-14

State Law requires that this report be prepared by the license holder responsible for the work and filed with the Department at the above address within 30 days of completion of drilling of the well or borehole.

<p style="text-align: center;">Well Owner Information (Landowner if borehole is not for a water well)</p> <p>Owner Name: <u>Troy Hall</u></p> <p>Mailing Address: _____ <u>1689 Hwy 472</u></p> <p><u>Pinola</u> <u>MS</u> <u>39149</u></p> <p>City State Zip Code</p> <p>Telephone No. <u>(601) 847-5215</u></p>	<p style="text-align: center;">Well or Borehole Location <u>90° 15' 5"</u></p> <p>Latitude: <u>31° 09.182</u> Longitude: <u>090° 15.093</u></p> <p>Method of Lat/Long (check one): Conventional Survey _____, ✓ USGS quad _____, Hand-held GPS _____, Survey-grade GPS _____</p> <p><u>NW</u> $\frac{1}{4}$ <u>SE</u> $\frac{1}{4}$, Sec <u>7</u>¹² T <u>2N</u> R <u>10E</u></p> <p><u>6</u> Miles <u>W</u> of <u>Tylertown</u></p> <p>(Distance) (Direction) (Nearest Town)</p>
--	---

<p>Well / Borehole Data</p>
<p>Date drilling started: <u>11-11-14</u> Date drilling completed: <u>11-11-14</u> Hole depth: <u>170</u> Hole diameter: <u>7 1/2"</u></p> <p>Location of the source of any surface water used for drilling: <u>running creek</u></p> <p>Method of dosing and volume of Chlorine used in drilling and development: <u>granule chlorine</u></p> <p>Logs run (circle all applicable): <input checked="" type="radio"/> No log run <input type="radio"/> Electric <input type="radio"/> Gamma Ray <input type="radio"/> Density <input type="radio"/> Sonic <input type="radio"/> Neutron <input type="radio"/> Other: _____</p> <p>Name of organization running log(s): _____</p> <p>Purpose of borehole (circle one): <input checked="" type="radio"/> Water Well <input type="radio"/> Geotechnical/Geological Investigation <input type="radio"/> Ground Source Heat Pump <input type="radio"/> Seismic Survey <input type="radio"/> Other (describe) _____</p> <p style="text-align: center;"><i>If drilling is not related to water well construction, skip the remainder of this block</i></p> <p>Purpose of Well (circle all applicable): <input checked="" type="radio"/> Home <input type="radio"/> Industrial <input type="radio"/> Public Supply <input type="radio"/> Irrigation <input type="radio"/> Fish Culture</p> <p>Other (describe): _____</p> <p>If a flowing well, method of flow regulation: Valve _____ Other (describe) _____</p> <p>Static Water Level: <u>60</u> feet [above or <input checked="" type="radio"/> below] land surface Date measured: <u>11-11-14</u> (circle one)</p> <p>Method of measurement (circle one): <input checked="" type="radio"/> Steel tape <input type="radio"/> Electric tape <input type="radio"/> Air line <input type="radio"/> Other (describe): _____</p> <p>Well depth: <u>170</u> Well grouted to a depth of: <u>10</u> feet Type of grout (circle one): <input checked="" type="radio"/> Neat Cement <input type="radio"/> Bentonite Mix</p> <p>Casing length: <u>150</u> feet Casing diameter: <u>4</u> inches Type of casing: <u>PVC</u></p> <p>Screen length: <u>20</u> feet Screen diameter: <u>4</u> inches Type of screen: <u>PVC</u></p> <p>Screen slot size: <u>.008</u> inches Setting depth: From <u>150</u> feet to <u>170</u> feet</p> <p>Type of completion (circle all applicables): <input checked="" type="radio"/> Gravel packed <input type="radio"/> Underreamed <input type="radio"/> Open hole <input type="radio"/> Natural Development</p> <p>Other (describe): _____</p> <p>Top of lap pipe or reduction in casing: _____ feet</p>

If telescoped or more than one screen, describe on next page


RECEIVED
DEC 24 2014

County: Walton
 Permit #: _____

For Office Use Only:
 Well #: E231

The sketch below only required for water wells
If well telescopes, show depths on sketch.

Description of formations encountered must be provided for all wells and boreholes, unless specifically exempted by regulations

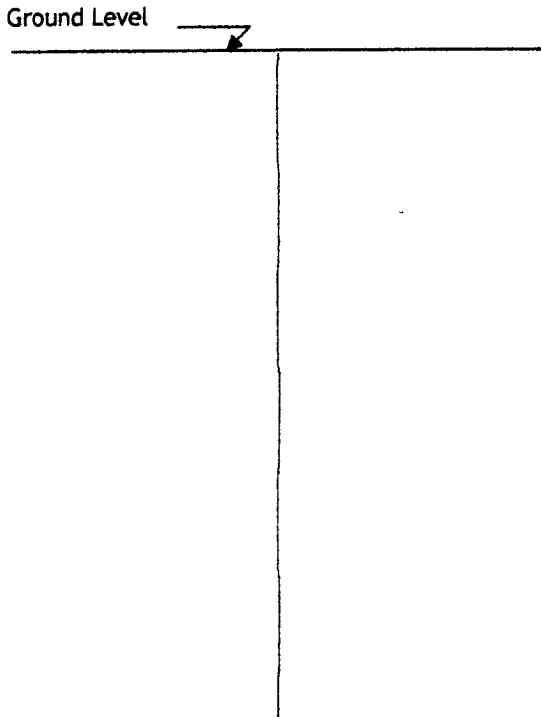


Description of Formations Encountered	From (depth)	To (depth)
topsoil	Ground level	1
clay	1	25
sand	25	37
clay	37	130
sand	130	170

If more than one screen. show location of each on sketch

Sketch the property layout and include the following:

- 1) the well location
- 2) any permanent structures on the property that may aid in locating the well
- 3) any roads, power lines, or other items that may aid in locating the property and the well
- 4) north arrow

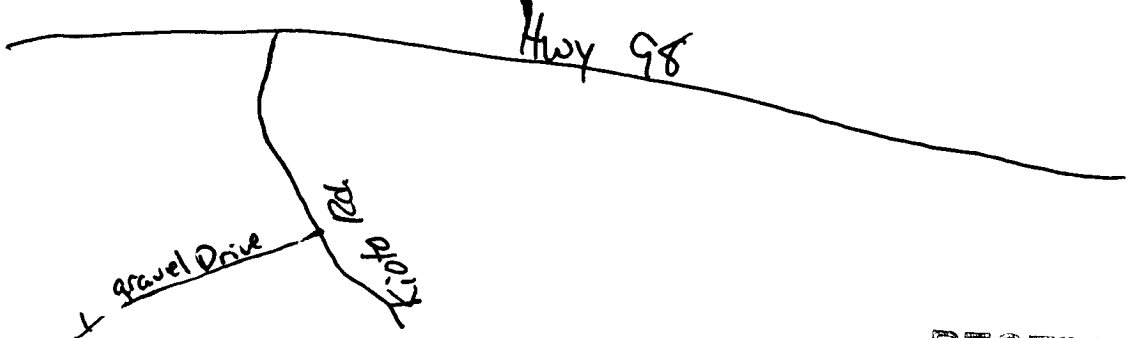

RECEIVED
 DEC 24 2014
 BY: OLWRS

Landowner Name: Troy Hall

I HEREBY CERTIFY that the well/borehole was drilled, constructed, and completed in accordance with all applicable requirements of the Mississippi Department of Environmental Quality and the Mississippi Department of Health regulations, if applicable, and state laws.

James M. Wells 00005889
 Print Name of Responsible Licensee and License No.

 Date

James M. Wells
 Signature of Licensee

STATE WELL REPORT

Part 2

Pump Installer's Completion Report
Mississippi Department of Environmental Quality
Office of Land and Water Resources
P.O. Box 2309
Jackson, MS 39225-2309
(601)961-5210
(601) 360-0535 (fax)

County: Walshall
Permit #: _____
Driller: James M. Wells
Date completed: 11-11-14
Copy information from block on Part 1

For Office Use Only:
Well #: E231
Aquifer: _____

This part of the report must be completed by a licensed water well contractor or a licensed pump installer. A copy of Part 1 of the report must be attached and both parts filed with the Department at the above address within 30 days of well completion.

Well Owner Information Owner Name: <u>Troy Hall</u> Mailing Address: _____ <u>1689 Hwy 472</u> <u>Pinola MS 39149</u> City State Zip Code Telephone No. (<u>601</u>) <u>847-5215</u>	Well Location <u>31° 09' 10" N 90° 15' 05" W</u> Latitude: <u>31° 09.182</u> Longitude: <u>090° 15.093</u> Method of Lat/Long (check one): Conventional Survey _____, <input checked="" type="checkbox"/> USGS quad _____, Hand-held GPS _____, Survey-grade GPS _____ _____/_____/_____, Sec <u>7</u> T <u>2N</u> R <u>10E</u> <u>6</u> Miles <u>W</u> of <u>Tylertown</u> (Distance) (Direction) (Nearest Town)
---	--

Pump Type (circle one)
 Submersible Turbine Air Lift Centrifugal Flowing Well Jet Piston Rotary Other (describe): _____
Date Pump Installed: 11-11-14 Rated Pump Capacity: 12 Gallons Per Minute
Is This Pump (circle one): New Repaired Replacement

Power Type (circle one)
 Electric Diesel Gasoline Natural Gas Tractor PTO Windmill Other (describe): _____
Horse Power Rating of Motor: 1 Setting Depth: 100 feet Number of Stages: 14

Pump Test Data for Non Flowing Well
Date Well Tested: 11-11-14 Duration of Pump Test (minimum 4 hours): 4 hours
Static Water Level (A): 60 Feet Below Land Surface Pumping Water Level (B): 100 Feet Below Land Surface
Drawdown [(B) - (A)]: 6840 Feet Below Land Surface Test Pumping Rate: 18 Gallons Per Minute
Method of measurement (circle one): Steel tape Electric tape Air line Other (describe): _____

Pump Test Data for Flowing Well
Measured shut in head: _____ feet.
Well yielded _____ GPM with a drawdown of _____ feet after _____ hours of pumping

Meter Installation
Meter Manufacturer: _____ Meter Serial Number: _____ **RECEIVED**
Meter Model Number/Name: _____ Type of Meter: _____
Totalizer Register Unit and Multiplier Factor (AF x .001, gal x 1000, etc): _____ **DEC 24 2014**
Installation Date: _____ Meter installed by: _____
Is This Meter (circle one): New Repaired Replacement
Important: By submitting the above information you are certifying that this meter was installed to manufacturer standards. For agricultural wells, a list of approved meters is on the MDEQ website.

I HEREBY CERTIFY that the above statements are true to the best of my knowledge.
James M. Wells 00005889 _____
Print Name of Pump Installer and License No. (if applicable) Date Signature of Pump Installer