

WALTHALL MISSISSIPPI BOARD OF WATER COMMISSIONERS

~~HE~~ E 2000

9-27-62

WATER WELL DRILLERS LOG

Date: 9-27, 1962, Driller: EB. SHEPARD County WALTHALL
(Name)

(1) Owner of Land: ROBERT CORNELL
(Name)
TYLER TOWN, MISS
(Address)
(2) Location: 1/4, 27-2-10, Sec. T R
3 1/2 miles S.W., of TYLERTOWN
(distance) (direction) (Nearest Town)
(3) Topography: (Hilly) (Flat) (Level)
(4) Purpose of Well: (Domestic Irrigation)
 (Municipal, Industrial, Other)

Description & Color of Materials Sand, Clay, Red Clay, Shell, etc.	Thick- ness Feet	Depth Feet
RED SANDY CLAY		0-
" " "		20-
" " "		30-
" " "		40-
" " "		50-
SAND PEA GRAVEL		60-
		70-


Information upon completion of well:

- (1) Diameter 2 inches.
(2) Total Depth 70 feet.
(3) Water level 55 feet below top of ground.
(4) Cased to 70, Size 2"
(5) Screen: Size 2", Length 5"
(6) Were any formations sealed against pollution?
_____ yes, no.

If YES depth of formation _____

Why _____

Drillers. Remarks: _____

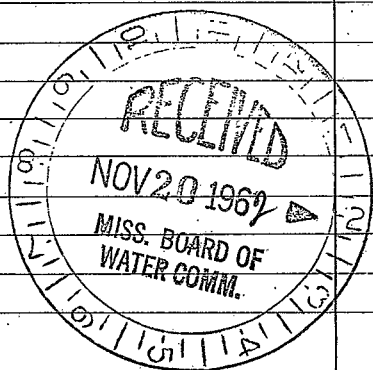

(Use Back Side)

Well No.

99020000

Faint, illegible text scattered across the page, possibly bleed-through from the reverse side.