

Walthall  
E 2003  
9-5-75

MISSISSIPPI  
 BOARD OF WATER COMMISSIONERS  
 416 North State Street  
 Jackson, Mississippi 39201

WATER WELL DRILLERS LOG

Sept 5 19 75 Drummond Drilling Walthall  
 date well completed firm name county well located

LANDOWNER:  
Mr. L. H. Holmes  
Rt. 1, Lyletown  
 (mailing address)

description of formations encountered	from	to
<u>clay</u>	<u>0</u>	<u>15</u>
<u>sand &amp; gravel</u>	<u>15</u>	<u>93</u>
<u>blue chalk</u>	<u>93</u>	<u>160</u>
<u>mixed chalk sand</u>	<u>160</u>	<u>178</u>
<u>coarse sand</u>	<u>178</u>	<u>190</u>

WELL LOCATION:  
 sec. 7 T. 2 N. R. 7 E  
6 miles W of Lyletown  
 (distance) (direction) (nearest town)

WELL PURPOSE: home  
 (home, irrigation, municipal, industrial)

- WELL COMPLETION DATA:
- (1) diameter (inches) 4"
  - (2) total depth (feet) 190
  - (3) static water level (feet) 90 below/above top of ground.
  - (4) casing plastic, battery (material) (depth)
  - (5) screen 6' (length) 184 (depth to top)
  - (6) pump 1/2 (HP) 10 (yield gpm)
  - (7) electric log no (yes or no)
  - (organization running log)


(8) how well bottom plugged  
wooden plug

DRILLERS REMARKS:  
old 2" well Drilling

RECEIVED  
 JAN 2 1976

If well telescopes please sketch and show depths.

GROUND LEVEL

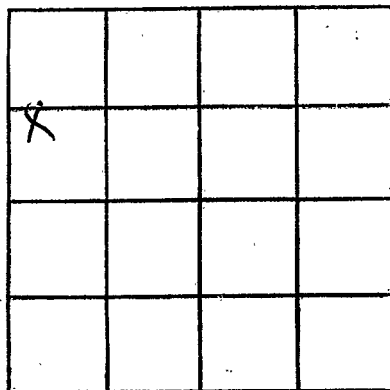

SECTION 7

Please indicate well location X.

ADDITIONAL INFORMATION

If more than one screen,  
show locations of each on sketch.