

Walshall  
E 2004  
10/75

MISSISSIPPI  
BOARD OF WATER COMMISSIONERS  
416 North State Street  
Jackson, Mississippi 39201

WATER WELL DRILLERS LOG

Oct. 1975 E.B. Sherrard Walshall  
date well completed firm name county well located

LANDOWNER:  
Johnnie Lee Chain  
Iylertown, Ms.  
(mailing address)

description of formations encountered	from	to
RED SANDY CLAY	0	40'
COARSE SAND + DEA GR.	40	87'

WELL LOCATION:  
sec 14 T 2 N R 10 E 13U  
1 1/2 miles N W Iylertown  
(distance) (direction) (nearest town)

WELL PURPOSE:  
(home) Irrigation, municipal, industrial

- WELL COMPLETION DATA:
- (1) diameter (inches) 2"
  - (2) total depth (feet) 82'
  - (3) static water level (feet) 36' <sup>below</sup> above top of ground.
  - (4) casing pl. 77' (material) (depth)  
2" (size) if telescope see back.
  - (5) screen 5' (length) (depth to top)  
2" (size) pl. (material)
  - (6) pump 3/4 (HP) 7 (yield gpm)  
E (type power)
  - (7) electric log (yes or no)
  - (organization running log)
  - (8) how well bottom plugged B W V


REGISTERED  
DEC 5 1975

MISS. BD. OF WATER COMMISSIONERS

DRILLERS REMARKS:

If well telescopes please sketch and show depths.

GROUND LEVEL

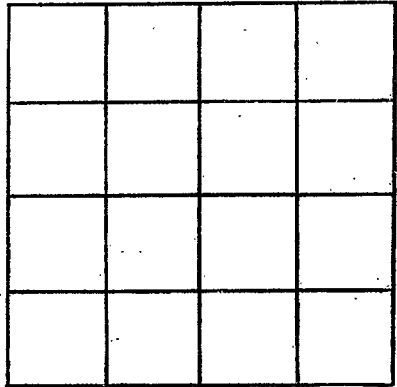

SECTION \_\_\_\_\_

Please indicate well location X.

ADDITIONAL INFORMATION

A series of horizontal lines providing space for additional information.

If more than one screen, show locations of each on sketch.