

WALTHALL
 E 2000
 12-9-75

MISSISSIPPI
 BOARD OF WATER COMMISSIONERS
 416 North State Street
 Jackson, Mississippi 39201

WATER WELL DRILLERS LOG

WALTHALL

Dec-9 1975 Revere Well Dr Five
 date well completed. firm name county well located

LANDOWNER:
Rugh Washington
Thompson Job
 (mailing address)

description of formations encountered	from	to
Clay	0	20
Red sand	20	43
Chalk sand	43	118
sand & fine gravel	118	132

WELL LOCATION:
 sec. 1 T. 2 N. R. 10 E.
3 miles S-SE of Hamville
 (distance) (direction) (nearest town)

WELL PURPOSE: home
 (home, irrigation, municipal, industrial)

- WELL COMPLETION DATA:
- (1) diameter (inches) 4"
 - (2) total depth (feet) 132
 - (3) static water level (feet) 64 below top of ground.
 - (4) casing plastic bottom
 (material) (depth)
 - If telescope see back.
 (size)
 - (5) screen 6' 126
 (length) (depth to top)
 - 4' plastic
 (size) (material)
 - (6) pump 3/7 12
 (HP) (yield gpm)
 - elct
 (type power)
 - (7) electric log no
 (yes or no)
 - (organization running log)

(8) how well bottom plugged
Wooden plug


DRILLERS REMARKS:
New House

RECEIVED
 DECEMBER 11 1975
 JAN 28 1976

MISS. RD. OF WATER COMMISSIONERS

If well telescopes please sketch and show depths.

GROUND LEVEL

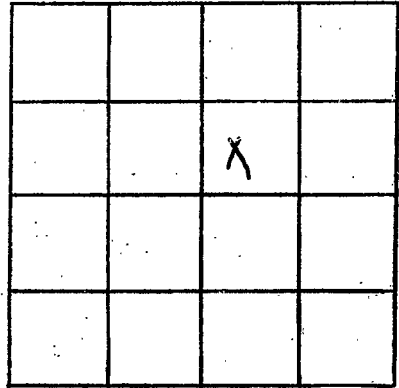

SECTION 1

Please indicate well location X.

ADDITIONAL INFORMATION

If more than one screen, show locations of each on sketch.