

Walthall

E 2007

12-4-75

MISSISSIPPI
 BOARD OF WATER COMMISSIONERS
 416 North State Street
 Jackson, Mississippi 39201

WATER WELL DRILLERS LOG

Walthall
Pike

Jan 4
date well completed

134 75
firm name


county well located

LANDOWNER:	description of formations encountered	from	to
Bobby E. Magee Rt 2 - Magnolia (mailing address)			
WELL LOCATION:			
sec. <u>6</u> T <u>2</u> N R. <u>7</u> E #			
<u>3</u> miles <u>S-SE</u> of <u>Hammett</u> (distance) (direction) (nearest town)			
WELL PURPOSE: <u>Home</u> (home, irrigation, municipal, industrial)			
WELL COMPLETION DATA:			
(1) diameter (inches) <u>1 1/2"</u>			
(2) total depth (feet) <u>126</u>			
(3) static water level (feet) <u>90</u> <u>above</u> top of ground.			
(4) casing <u>plastic, bottom</u> (material) (depth)			
<u> </u> if telescope see back. (size)			
(5) screen <u>6"</u> <u>120</u> (length) (depth to top)			
<u>1 1/2"</u> <u>plastic</u> (size) (material)			
(6) pump <u>1/2</u> <u>10</u> (HP) (yield gpm)			
<u>elect</u> (type power)			
(7) electric log <u>no</u> (yes or no)			
<u> </u> (organization running log)			
(8) how well bottom plugged <u>1/2" sand plug</u>			
DRILLERS REMARKS: <u>New House Site</u>			

MISSISSIPPI
 BOARD OF WATER COMMISSIONERS
 JAN 28 1976
 MISS. BD. OF WATER COMMISSIONERS

If well telescopes please sketch and show depths.

GROUND LEVEL

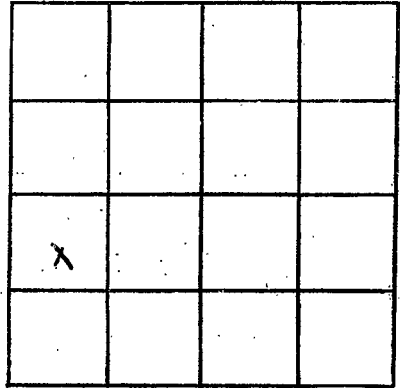

SECTION 6

Please indicate well location X.

ADDITIONAL INFORMATION

If more than one screen, show locations of each on sketch.