

WALTHALL  
E 2008  
Jan '76

MISSISSIPPI  
 BOARD OF WATER COMMISSIONERS  
 416 North State Street  
 Jackson, Mississippi 39201

WATER WELL DRILLERS LOG

JAN. 1976 E.B. SHERBARD WALTHALL  
 date well completed firm name county well located

LANDOWNER:

MAVIS BAUGHMAN  
TYBERTOWN, Miss.  
 (mailing address)

description of formations encountered

	from	to
<u>RED SANDY CLAY</u>	<u>0</u>	<u>45'</u>
<u>STRAKS SAND</u>		
<u>CLAY &amp; GRAVEL</u>	<u>45'</u>	<u>100'</u>
<u>SAND &amp; GRAVEL</u>	<u>100'</u>	<u>135'</u>

WELL LOCATION:

sec. 31 T. 2 N. R. 10 E.  
5 miles SW of TYBERTOWN  
 (distance) (direction) (nearest town)

WELL PURPOSE:

Home Irrigation, municipal, industrial)

WELL COMPLETION DATA:

- (1) diameter (inches) 2"
- (2) total depth (feet) 135'
- (3) static water level (feet) 60' <sup>below</sup> <sub>above</sub> top of ground.
- (4) casing pl. 130'  
 (material) (depth)  
2" if telescope see back.  
 (size)
- (5) screen 5' pl.  
 (length) (depth to top)  
2" pl.  
 (size) (material)
- (6) pump 1 7  
 (HP) (yield gpm)  
e  
 (type power)
- (7) electric log (yes or no)  
(organization running log)
- (8) how well bottom plugged BWV


DRILLERS REMARKS:

**RECEIVED**

OCT 18 1976

If well telescopes please sketch and show depths.

GROUND LEVEL

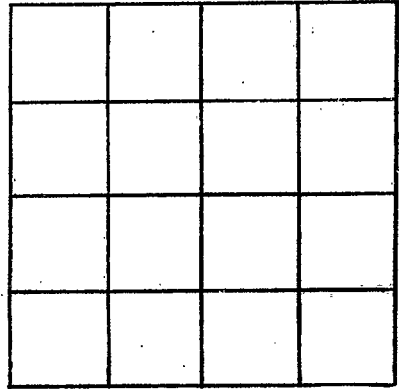

SECTION \_\_\_\_\_

Please indicate well location X.

ADDITIONAL INFORMATION

If more than one screen, show locations of each on sketch.