

**WALTHALL**  
 E 2009  
 2-28-76

MISSISSIPPI  
 BOARD OF WATER COMMISSIONERS  
 416 North State Street  
 Jackson, Mississippi 39201

WATER WELL DRILLERS LOG

28 Feb 1976 Amos Parker Well Services county well located  
 date well completed firm name

LANDOWNER:  
 Claude Holmes  
 Tipton  
 (mailing address)

description of formations encountered	from	to
clay	0	20
soft shale	20	45
sand	45	60
clay	60	75
sand	75	114

WELL LOCATION:  
 sec. 9 T. 20 N. R. 10 E.  
 4 miles NW of Tipton  
 (distance) (direction) (nearest town)

WELL PURPOSE:  
 (home, irrigation, municipal, industrial)

- WELL COMPLETION DATA:
- (1) diameter (inches) 4
  - (2) total depth (feet) 114
  - (3) static water level (feet) 80 below top of ground.
  - (4) casing (material) PL, (depth) 108
  - (size) if telescope see back.
  - (5) screen (length) 6, (depth to top) 108
  - (size) 4, (material) PL
  - (6) pump (HP) (yield gpm)
  - (type power) None
  - (7) electric log (yes or no)
  - (organization running log)
  - (8) how well bottom plugged


REGISTERED  
 APR 29 1976

DRILLERS REMARKS:

MISS. BD. OF WATER COMMISSIONERS

If well telescopes please sketch and show depths.

GROUND LEVEL

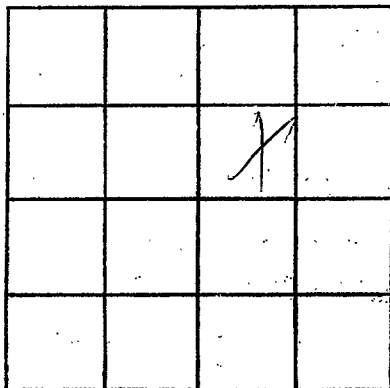

SECTION 9

Please indicate well location X.

ADDITIONAL INFORMATION

If more than one screen, show locations of each on sketch.