

WALTHALL

E 2010

3-16-76

MISSISSIPPI BOARD OF WATER COMMISSIONERS
416 North State Street
Jackson, Mississippi 39201

WATER WELL DRILLERS LOG

3-16
date well completed

1976

Fitzgerald Well Serv
firm name

Walthall
county well located

LANDOWNER:

Luther Bridges

R.R. Tylston, Miss.
(mailing address)

description of formations encountered

from

to

Red Clay	0	20
Red Sand	20	90
Coarse sand & gravel	90	120

WELL LOCATION:


sec. 11 T 2 N R 10 E
S W
3 miles NW of Tylston
(distance) (direction) (nearest town)

WELL PURPOSE: Home
(home, irrigation, municipal, industrial)

WELL COMPLETION DATA:

- (1) diameter (inches) 4
- (2) total depth (feet) 120
- (3) static water level (feet) 90 below top of ground.
- (4) casing PVC, 112 (material), (depth)
4 (size) If telescope see back.
- (5) screen 8, 112 (length), (depth to top)
4, PVC (size), (material)
- (6) pump 1/2, 10 (HP), (yield gpm)
Glen (type power)
- (7) electric log No (yes or no)
(organization running log)
- (8) how well bottom plugged Sand slush


DRILLERS REMARKS:

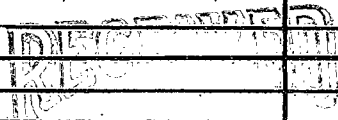

APR - 7 1976

If well telescopes please sketch and show depths.

GROUND LEVEL

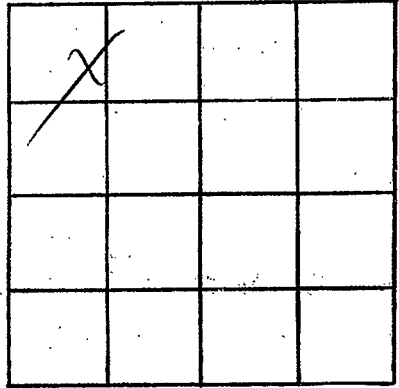

SECTION 11

Please indicate well location X.

ADDITIONAL INFORMATION

If more than one screen, show locations of each on sketch.