

Walthall
 E 2011
 6/28/76

MISSISSIPPI
 BOARD OF WATER COMMISSIONERS
 416 North State Street
 Jackson, Mississippi 39201

WATER WELL DRILLERS LOG

June 28 1976 *Reeves Well Ser* *Walthall*
 date well completed firm name county well located

LANDOWNER:
Louie Smith
Rt 3, Tylertown
 (mailing address)

WELL LOCATION:
 sec. *4* T. *22* N. R. *10* E
2 miles *south* of *Musa*
 (distance) (direction) (nearest town)

WELL PURPOSE: *home*
 (home, irrigation, municipal, industrial)

- WELL COMPLETION DATA:
- (1) diameter (inches) *4"*
 - (2) total depth (feet) *140*
 - (3) static water level (feet) *105* below top of ground.
 - (4) casing *plastic bottom*
 (material) (depth)
 - (size) if telescope see back.
 - (5) screen *6"* *134*
 (length) (depth to top)
 - 4"* *plastic*
 (size) (material)
 - (6) pump *beattus*
 (HP) (yield gpm)
 - elect*
 (type power)
 - (7) electric log *no*
 (yes or no)
 - (organization running log)

(8) how well bottom plugged
wooden plug

DRILLERS REMARKS:
old well hit by lightning


description of formations encountered	from to	
<i>Red Clay</i>	<i>0</i>	<i>20</i>
<i>Red sand</i>	<i>20</i>	<i>87</i>
<i>hard ground</i>	<i>87</i>	<i>102</i>
<i>loose sand</i>	<i>102</i>	<i>125</i>
<i>plastic</i>	<i>125</i>	<i>140</i>

RECEIVED

OCT 22 1976

If well telescopes please sketch and show depths.

GROUND LEVEL

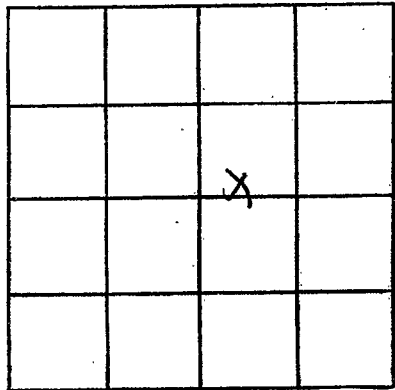

SECTION 4

Please indicate well location X.

ADDITIONAL INFORMATION

If more than one screen, show locations of each on sketch.