

WALTHALL
E 2012
10-12-76

MISSISSIPPI
 BOARD OF WATER COMMISSIONERS
 416 North State Street
 134 Jackson, Mississippi 39201

WATER WELL DRILLERS LOG

10-12 date well completed 1976 Lyonsville Inc firm name Walthall county well located


LANDOWNER:	description of formations encountered	from	to
<u>Claude Brister</u>			
<u>R.R. Lyntown</u> (mailing address)	<u>Red clay</u> <u>Red sand</u> <u>Coarse sand & gravel</u>	<u>0</u> <u>20</u> <u>80</u>	<u>20</u> <u>80</u> <u>95</u>
WELL LOCATION:			
sec. <u>8</u> T. <u>2</u> (N) R. <u>10</u> (E) <u>0.1</u> miles (distance) <u>W</u> (direction) of <u>Lyntown</u> (nearest town)			
WELL PURPOSE: <u>Home</u> (home, irrigation, municipal, industrial)			
WELL COMPLETION DATA:			
(1) diameter (inches) <u>4</u>			
(2) total depth (feet) <u>95</u>			
(3) static water level (feet) <u>10</u> below above top of ground.			
(4) casing <u>PVC</u> <u>87</u> (material) (depth)			
<u>4</u> if telescope see back. (size)			
(5) screen <u>8</u> <u>87</u> (length) (depth to top)			
<u>4</u> <u>PVC</u> (size) (material)			
(6) pump <u>1/2</u> <u>10</u> (HP) (yield gpm)			
<u>Class</u> (type power)			
(7) electric log <u>no</u> (yes or no)			
(organization running log)			
(8) how well bottom plugged <u>sealed</u>			
DRILLERS REMARKS:			

RECEIVED
 OCT 18 1976

Miss. BD. OF WATER COMMISSIONERS

If well telescopes please sketch and show depths.

GROUND LEVEL

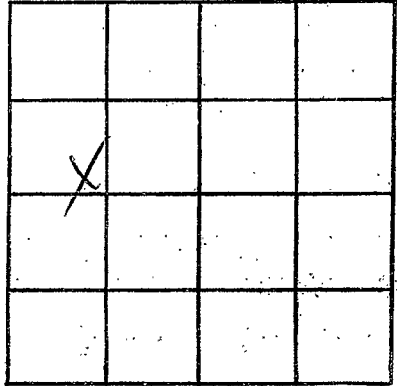

SECTION 8

Please indicate well location X.

ADDITIONAL INFORMATION

If more than one screen,
show locations of each on sketch.