

WALTHALL

E 2014

11-22-76

MISSISSIPPI BOARD OF WATER COMMISSIONERS 416 North State Street Jackson, Mississippi 39201

WATER WELL DRILLERS LOG

11-22 date well completed

1976 Filanah Well Service Walthall firm name

county well located

LANDOWNER:

Charles Ray Stinson

R.R. Lybenton (mailing address)

description of formations encountered

from

to

Red clay

0 20

Red sand

20 80

Coarse sand & gravel

80 92

WELL LOCATION:

sec. 1 T. 20 N. R. 10 E

2 1/2 miles N of Lybenton (distance) (direction) (nearest town)

WELL PURPOSE: Home (home, irrigation, municipal, industrial)

WELL COMPLETION DATA:

- (1) diameter (inches) 4
(2) total depth (feet) 92
(3) static water level (feet) 58 below top of ground.
(4) casing PVC, 84 (material) (depth)
4 (size) if telescope see back.
(5) screen 8, 84 (length) (depth to top)
4, PVC (size) (material)
(6) pump 1/2, 10 (HP) (yield gpm)
also (type power)
(7) electric log No (yes or no)
(organization running log)
(8) how well bottom plugged sand shak


RECEIVED DEC 23 1976

DRILLERS REMARKS:

MISS. Bd. OF WATER

If well telescopes please sketch and show depths.

GROUND LEVEL

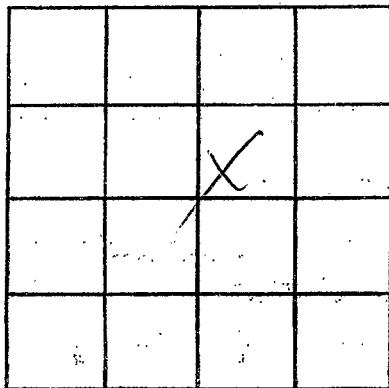

SECTION 1

Please indicate well location X.

ADDITIONAL INFORMATION

If more than one screen,
show locations of each on sketch.