

WALTHALL
E 2015
7/29/76

MISSISSIPPI
BOARD OF WATER COMMISSIONERS
416 North State Street
Jackson, Mississippi 39201

WATER WELL DRILLERS LOG

7-29 date well completed 13W 76 firm name Walthall county well located

LANDOWNER:
Montiella Forest Products
R.R. Lybster Min.
(mailing address)

description of formations encountered	from	to
Red clay	0	20
Red gravel	20	90
Red gravel	90	120
Coarse sand & gravel	120	130

WELL LOCATION:
sec. 22 T 20 N R 10 E
S S W
2 miles W of Lybster
(distance) (direction) (nearest town)

WELL PURPOSE: Home
(home, irrigation, municipal, industrial)

- WELL COMPLETION DATA:
- (1) diameter (inches) 4
 - (2) total depth (feet) 130
 - (3) static water level (feet) 80 below top of ground.
 - (4) casing PVC, 122 (material) (depth)
4 (size) if telescope see back.
 - (5) screen 8, 122 (length) (depth to top)
4 (size) PVC (material)
 - (6) pump 1/2, 10 (HP) (yield gpm)
Glow (type power)
 - (7) electric log No (yes or no)
(organization running log)
 - (8) how well bottom plugged Sand fill

DRILLERS REMARKS:


RECEIVED

AUG 20 1976

MISS. BD. OF WATER COMM

If well telescopes please sketch and show depths.

GROUND LEVEL

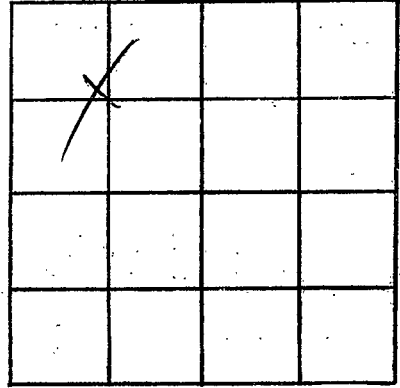

SECTION 22

Please indicate well location X.

ADDITIONAL INFORMATION

If more than one screen, show locations of each on sketch.