

WALTHALL  
E 2017  
12-28-76

MISSISSIPPI  
BOARD OF WATER COMMISSIONERS  
416 North State Street  
Jackson, Mississippi 39201

WATER WELL DRILLERS LOG

Dec 28 1976 Reynolds Sewer Walthall  
date well completed firm name county well located

LANDOWNER:  
Mrs. Lilly C. Walthall  
Rt. Tyltoman  
(mailing address)

description of formations encountered	from	to
Clay	0	5
Clay & gravel	5	20
Shale	20	60
pea gravel & sand	60	81

WELL LOCATION:  
sec. 14 T. 2 N. R. 10 E  
2 miles SW of Tyltoman  
(distance) (direction) (nearest town)

WELL PURPOSE: home  
(home, irrigation, municipal, industrial)

- WELL COMPLETION DATA:
- (1) diameter (inches) 4"
  - (2) total depth (feet) 81
  - (3) static water level (feet) 20 below top of ground.
  - (4) casing plastic, bottom  
(material) (depth)
  - if telescope see back.  
(size)
  - (5) screen 6' 75'  
(length) (depth to top)
  - 4" plastic  
(size) (material)
  - (6) pump 1/2 HP 6  
(HP) (yield gpm)
  - 1/2 HP  
(type power)
  - (7) electric log No.  
(yes or no)
  - (organization running log)

(8) how well bottom plugged  
Woods plug


DRILLERS REMARKS:

RECEIVED  
FEB - 7 1977

MISS. BD. OF WATER COMMISSIONERS

If well telescopes please sketch and show depths.

GROUND LEVEL

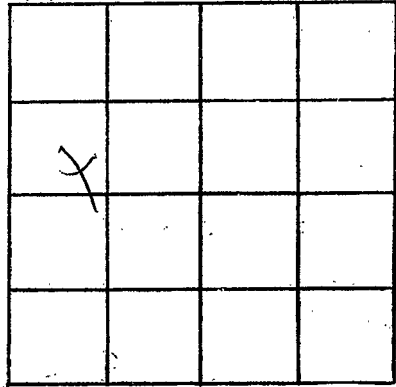

SECTION 14

Please indicate well location X.

ADDITIONAL INFORMATION

If more than one screen,  
show locations of each on sketch.