

WALTHALL
E 2018
3-30-77

MISSISSIPPI
BOARD OF WATER COMMISSIONERS
416 North State Street
Jackson, Mississippi 39201

25

WATER WELL DRILLERS LOG

March 30 1977 Reverend Miller Walthall
date well completed firm name county well located

LANDOWNER:
Carl McCain
At Fyletown
(mailing address)

description of formations encountered	from	to
<u>Red Clay</u>	<u>0</u>	<u>15</u>
<u>Red sand</u>	<u>15</u>	<u>60</u>
<u>Small gravel</u>	<u>60</u>	<u>73</u>
<u>Pink chalk</u>	<u>73</u>	<u>96</u>
<u>Coarse sand</u>	<u>96</u>	<u>117</u>

WELL LOCATION:
sec. 23 T. 2 N. R. 10E
1 1/2 miles WEST of Fyletown
(distance) (direction) (nearest town)

WELL PURPOSE: home
(home, irrigation, municipal, industrial)


WELL COMPLETION DATA:
(1) diameter (inches) 4"
(2) total depth (feet) 117
(3) static water level (feet) 90 below above top of ground.
(4) casing plastic, bottom
(material) (depth)
1 if telescope see back.
(size)
(5) screen 6", 111'
(length) (depth to top)
4", plastic
(size) (material)
(6) pump 1/2 10
(HP) (yield gpm)
split
(type power)
(7) electric log no
(yes or no)
(organization running log)

(8) how well bottom plugged
water plug
DRILLERS REMARKS:

RECEIVED
AUG 4 1977

If well telescopes please sketch and show depths.

GROUND LEVEL

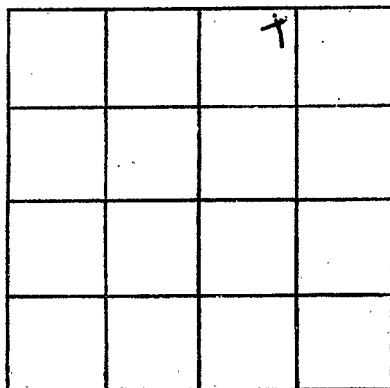

SECTION 23

Please indicate well location X.

ADDITIONAL INFORMATION

If more than one screen, show locations of each on sketch.