

WALTHALL
E 2019
6-14-77

MISSISSIPPI
BOARD OF WATER COMMISSIONERS
 416 North State Street
 Jackson, Mississippi 39201

WATER WELL DRILLERS LOG

6-14 1977 Stanford Lee Walthall
 date well completed firm name county well located

LANDOWNER:

Roy Comans

R.R. White
 (mailing address)

WELL LOCATION:

sec. 23 T. 2 N. R. 10 E
 S W

2 miles W of Hydston
 (distance) (direction) (nearest town)

WELL PURPOSE:

Home
 (home, irrigation, municipal, industrial)

WELL COMPLETION DATA:

- (1) diameter (inches) 4
- (2) total depth (feet) 130
- (3) static water level (feet) 85 below above top of ground.
- (4) casing PVC 122
 (material) (depth)
4 if telescope see back.
 (size)
- (5) screen 8 122
 (length) (depth to top)
4 PVC
 (size) (material)
- (6) pump 1/2 18
 (HP) (yield gpm)
elec
 (type power)
- (7) electric log no
 (yes or no)
no
 (organization running log)
- (8) how well bottom plugged solid

description of formations encountered

from to

<u>Red clay</u>	<u>0</u>	<u>20</u>
<u>Red soil</u>	<u>20</u>	<u>60</u>
<u>Red clay</u>	<u>60</u>	<u>120</u>
<u>House sand & gravel</u>	<u>120</u>	<u>130</u>


DRILLERS REMARKS:

RECEIVED

JUN 29 1977

If well telescopes please sketch and show depths.

GROUND LEVEL

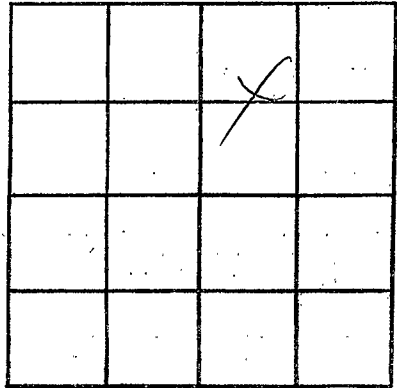

SECTION 23

Please indicate well location X.

ADDITIONAL INFORMATION

If more than one screen,
show locations of each on sketch.