

WALTHALL  
E 2020  
12-11-77

MISSISSIPPI  
 BOARD OF WATER COMMISSIONERS  
 416 North State Street  
 1324 Jackson, Mississippi 39201

WATER WELL DRILLERS LOG

Dec-11 19 77 Recess well for Walthall  
 date well completed firm name county well located

LANDOWNER:  
Miss. Mary Magee  
Rt 5 Tipton  
 (mailing address)

| description of formations encountered | from       | to         |
|---------------------------------------|------------|------------|
| <u>Red Clay</u>                       | <u>0</u>   | <u>18</u>  |
| <u>Red sand</u>                       | <u>18</u>  | <u>72</u>  |
| <u>Hard sand</u>                      | <u>72</u>  | <u>90</u>  |
| <u>White Chalk</u>                    | <u>90</u>  | <u>140</u> |
| <u>fine sand</u>                      | <u>140</u> | <u>162</u> |
| <u>Blue Chalk</u>                     | <u>162</u> | <u>230</u> |
| <u>Coarse sand</u>                    | <u>230</u> | <u>250</u> |

WELL LOCATION:  
 sec. 6 T 2 N R 2 E  
6 1/2 miles N.W. of Tipton  
 (distance) (direction) (nearest town)

WELL PURPOSE: Trailer  
 (home, irrigation, municipal, industrial)

WELL COMPLETION DATA:

(1) diameter (inches) 4"

(2) total depth (feet) 250

(3) static water level (feet) 135 above top of ground.

(4) casing plastic bottom  
 (material) (depth)

         if telescope see back.  
 (size)

(5) screen 6" 244  
 (length) (depth to top)

4" plastic  
 (size) (material)

(6) pump 3/4 Sub 1.0  
 (HP) (yield gpm)

1/2 HP  
 (type power)

(7) electric log no  
 (yes or no)

          
 (organization running log)

(8) how well bottom plugged  
wooden plug


DRILLERS REMARKS:  
Rough well  
to make

**RECEIVED**  
 FEB - 7 1977

MISS. RD. OF WATER COMMISSIONERS

If well telescopes please sketch and show depths.

GROUND LEVEL

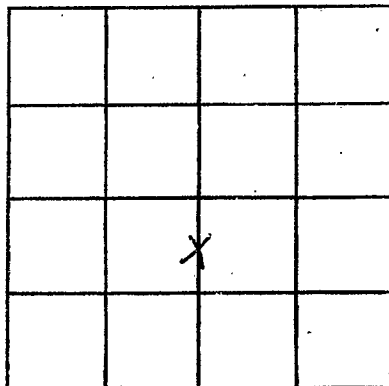

SECTION B

Please indicate well location X.

ADDITIONAL INFORMATION

If more than one screen,  
show locations of each on sketch.