

WALTHALL  
E 2021  
1-28-77

MISSISSIPPI  
BOARD OF WATER COMMISSIONERS  
416 North State Street  
Jackson, Mississippi 39201

8

WATER WELL DRILLERS LOG

Jan 28 1977 Primmer Well Service Walthall  
date well completed firm name county well located

LANDOWNER:  
Fletcher Moss  
P.O. Lexington  
(mailing address)

description of formations encountered	from	to
<u>Red clay</u>	<u>0</u>	<u>12</u>
<u>Mid level</u>	<u>12</u>	<u>30</u>
<u>Sand gravel</u>	<u>30</u>	<u>45</u>
<u>Shale</u>	<u>45</u>	<u>90</u>
<u>Sand &amp; gravel</u>	<u>90</u>	<u>125</u>

WELL LOCATION:  
sec. 15 T. 2 N R. 10 E  
3 miles W. NW of Lexington  
(distance) (direction) (nearest town)

WELL PURPOSE: house  
(home, irrigation, municipal, industrial)

WELL COMPLETION DATA:  
(1) diameter (inches) 4  
(2) total depth (feet) 128  
(3) static water level (feet) 80 below above top of ground.  
(4) casing plastic bottom (material) (depth)  
(size) if telescope see back.  
(5) screen 6" 100' (length) (depth to top)  
4" plastic (size) (material)  
(6) pump 1/2 10 (HP) (yield gpm)  
plastic (type power)  
(7) electric log no (yes or no)  
(organization running log)

(8) how well bottom plugged  
plastic


DRILLERS REMARKS:

RECEIVED  
FEB 18 1977

MISS. BD. OF WATER

If well telescopes please sketch and show depths.

GROUND LEVEL

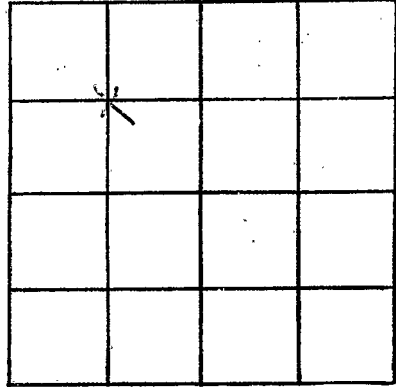

SECTION 15

Please indicate well location X.

ADDITIONAL INFORMATION

If more than one screen, show locations of each on sketch.