

WALTHALL
 E 2002
 4-16-77

MISSISSIPPI
 BOARD OF WATER COMMISSIONERS
 416 North State Street
 1306 Jackson, Mississippi 39201

33

WATER WELL DRILLERS LOG

April 16 19 77 Russell Well Inc Walthall
 date well completed firm name county well located

LANDOWNER:
Mrs. Selma Mae Magee
Rt 5 Tylertown
 (mailing address)

description of formations encountered	from	to
clay	0	18
Red sand	18	36
Gravel	36	50
limestone	50	103
sand & gravel	103	117

WELL LOCATION:
 sec 25 T 2 N R 10 E
1 miles West of Tylertown
 (distance) (direction) (nearest town)

WELL PURPOSE: home
 (home, irrigation, municipal, industrial)

- WELL COMPLETION DATA:
- (1) diameter (inches) 4"
 - (2) total depth (feet) 118
 - (3) static water level (feet) 70 below top of ground.
 - (4) casing plastic bottom
 (material) (depth)
 - 1 If telescope see back.
 (size)
 - (5) screen 6" 112
 (length) (depth to top)
 - 4" plastic
 (size) (material)
 - (6) pump 1/2 10
 (HP) (yield gpm)
 - elect
 (type power)
 - (7) electric log no
 (yes or no)
 - (organization running log)

(8) how well bottom plugged
wooden plug


DRILLERS REMARKS:

RECEIVED
 AUG 4 1977

MISS. RD. OF WATER COMM

If well telescopes please sketch and show depths.

GROUND LEVEL

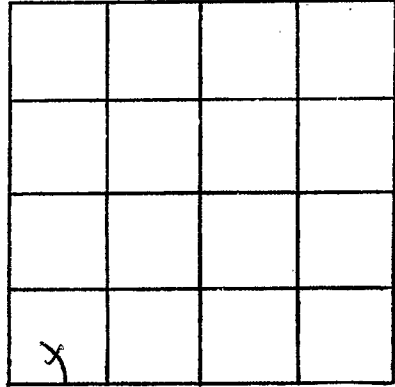

SECTION 25

Please indicate well location X.

ADDITIONAL INFORMATION

If more than one screen, show locations of each on sketch.