

WALTHALL
 E 2027
 10-21-78

MISSISSIPPI
 BOARD OF WATER COMMISSIONERS
 416 North State Street
 Jackson, Mississippi 39201

WATER WELL DRILLERS LOG

Oct 21 1978 Acme Well Service Walthall
 date well completed firm name county well located

LANDOWNER:
Mr. Simmons
Rt 2 W. Comb
 (mailing address)

description of formations encountered	from	to
<u>red clay</u>	<u>0</u>	<u>8</u>
<u>white sand</u>	<u>8</u>	<u>16</u>
<u>red gravel</u>	<u>16</u>	<u>28</u>

WELL LOCATION:
 sec. 25 T. 2 N. R. 10 E.
6 1/2 miles West of Tipton
 (distance) (direction) (nearest town)

WELL PURPOSE: residence
 (home, irrigation, municipal, industrial)

WELL COMPLETION DATA:

(1) diameter (inches) 4"

(2) total depth (feet) 28'

(3) static water level (feet) 16' below above top of ground.

(4) casing plastic bottom
 (material) (depth)
1/2" if telescope see back.
 (size)

(5) screen 5' 23'
 (length) (depth to top)
4" plastic
 (size) (material)

(6) pump 1/2 10
 (HP) (yield gpm)
elect
 (type power)

(7) electric log no
 (yes or no)
 (organization running log)

(8) how well bottom plugged wooden plug

DRILLERS REMARKS:


Miss. Board of Water Comm.

FEB 15 1979

RECEIVED

If well telescopes please
sketch and show depths.

GROUND LEVEL

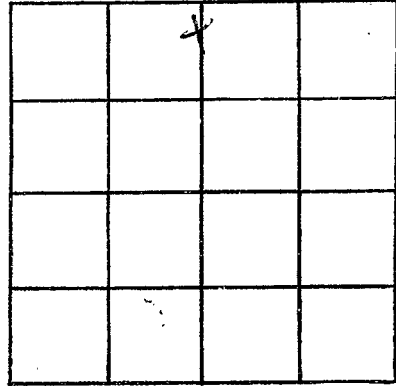

SECTION 25

Please indicate well location X.

ADDITIONAL INFORMATION

If more than one screen,
show locations of each on sketch.