

WALTHALL
E 2028
1/9/78

MISSISSIPPI
BOARD OF WATER COMMISSIONERS
416 North State Street
Jackson, Mississippi 39201

WATER WELL DRILLERS LOG

Jan. 9 1978 date well completed
Tom Griffith Plumbing + Walthall firm name well county well located

LANDOWNER:
Mrs. Ester Lee Ellzey
Rt. 1 Box 93, Tylertown, Miss.
(mailing address)

description of formations encountered	from	to
Top Soil	0	2
Clay	2	30
Clay	30	70
Sand	70	100

WELL LOCATION:
sec. 12 T. 2 N. R. 10 E.
2 miles N of Tylertown
(distance) (direction) (nearest town)

WELL PURPOSE: Home
(home, irrigation, municipal, industrial)

- WELL COMPLETION DATA:
- (1) diameter (inches) 2"
 - (2) total depth (feet) 100 ft.
 - (3) static water level (feet) 40 ft. below top of ground.
 - (4) casing Plastic 90 ft.
(material) (depth)
 - 2" if telescope see back.
(size)
 - (5) screen 10 ft., 90 ft.
(length) (depth to top)
 - 2" plastic
(size) (material)
 - (6) pump 1 (HP) 5 (yield gpm)
 - Elec
(type power)
 - (7) electric log ~~yes~~ NO
(yes/or no)

(organization running log)


(8) how well bottom plugged
B. W. Valve

DRILLERS REMARKS:

RECEIVED
MAR 31 1978

If well telescopes please sketch and show depths.

GROUND LEVEL

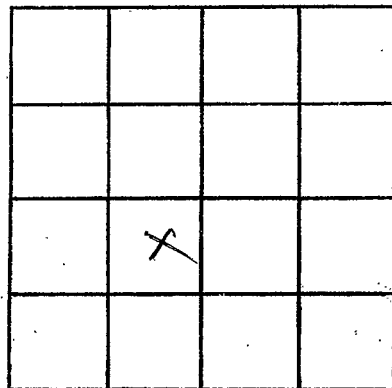

SECTION _____

Please indicate well location X.

ADDITIONAL INFORMATION

If more than one screen, show locations of each on sketch.