

WALTHALL

E 2009

4-5-78

MISSISSIPPI BOARD OF WATER COMMISSIONERS
416 North State Street
Jackson, Mississippi 39201

WATER WELL DRILLERS LOG

4-5
date well completed

19 78 Fitzgerald
firm name

Walthall
county well located

LANDOWNER:

United Electrical Assembly
R.R. Johnston
(mailing address)

description of formations encountered

from to

Red clay	0	20
Red gravel	20	60
Red sand	60	128
Coarse sand + gravel	128	140

WELL LOCATION:

sec. 15 T 2 N R 10 E
S W
2 miles W of Johnston
(distance) (direction) (nearest town)

WELL PURPOSE: Domestic
(home, irrigation, municipal, industrial)

WELL COMPLETION DATA:

- (1) diameter (inches) 4
- (2) total depth (feet) 140
- (3) static water level (feet) 90 below top of ground.
- (4) casing N.P.C. 132
(material) (depth)
4 if telescope see back.
(size)
- (5) screen 8 132
(length) (depth to top)
4 D.O.L.
(size) (material)
- (6) pump 3/4 15
(HP) (yield gpm)
Electric
(type power)
- (7) electric log no
(yes or no)
(organization running log)
- (8) how well bottom plugged Sealed

DRILLERS REMARKS:


RECEIVED

APR 27 1978

MISSISSIPPI BD. OF WATER COMMISSIONERS

If well telescopes please sketch and show depths.

GROUND LEVEL

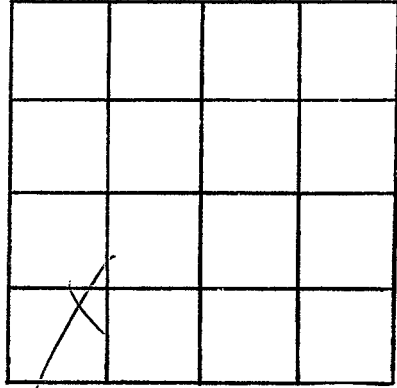

SECTION 15

Please indicate well location X.

ADDITIONAL INFORMATION

If more than one screen,
show locations of each on sketch.