

WALTHALL

E 3030

7-25-78

MISSISSIPPI BOARD OF WATER COMMISSIONERS 416 North State Street Jackson, Mississippi 39201

WATER WELL DRILLERS LOG

July 25 1978 Stuffed Well Son. Walthall Co. date well completed firm name county well located

LANDOWNER: Georg Wright

description of formations encountered from to

Jeferson Miss (mailing address)

top soil 0 2 sand clay 2 20

WELL LOCATION: sec. 2 T 2 N R 10 E S 24 1/2 W

chalk 30 80

5 miles S of Jeferson (distance) (direction) (nearest town)

fine sand 80 110

WELL PURPOSE: Home (home, irrigation, municipal, industrial)

sand 110 135

WELL COMPLETION DATA:

sand & gravel 135 150

(1) diameter (inches) 4" (2) total depth (feet) 150

(3) static water level (feet) below above top of ground.

(4) casing (material) plastic, 140 (depth) 4" (size) If telescope see back.

(5) screen 10ft, 140 (length) (depth to top) 4" plastic (size) (material)


(6) pump 1/2 (HP) (yield gpm) Elet (type power)

(7) electric log (yes or no)

(organization running log)

(8) how well bottom plugged B/w/c


DRILLERS REMARKS

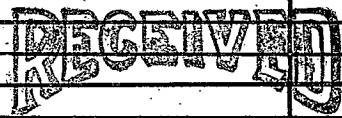

AUG 21 1978

If well telescopes please sketch and show depths.

GROUND LEVEL

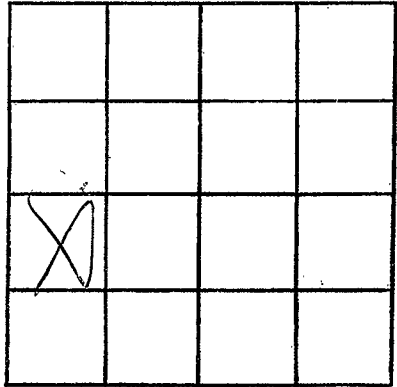

SECTION \_\_\_\_\_

Please indicate well location X.

ADDITIONAL INFORMATION

If more than one screen,  
show locations of each on sketch.