

WALTHALL
 E 2031
 7-17-78

MISSISSIPPI
 BOARD OF WATER COMMISSIONERS
 416 North State Street
 Jackson, Mississippi 39201

WATER WELL DRILLERS LOG

July 17 1978 Stofford Well Sr. Walthall Co.
 date well completed firm name county well located


LANDOWNER: George Wright
Jaytown Miss
 (mailing address)

WELL LOCATION:
 sec. 2 T 2 N R. 10 E
5 miles SE of Jaytown
 (distance) (direction) (nearest town)

WELL PURPOSE: Home
 (home, irrigation, municipal, industrial)

- WELL COMPLETION DATA:
- (1) diameter (inches) 4"
 - (2) total depth (feet) 130 ft.
 - (3) static water level (feet) _____ below
 top of ground. above
 - (4) casing plastic, 120,
 (material) (depth)
4"
 (size) if telescope see back.
 - (5) screen 10, 120
 (length) (depth to top)
4", plastic
 (size) (material)
 - (6) pump 1/2 (HP) _____ (yield gpm)
Elect
 (type power)
 - (7) electric log _____ (yes or no)
 (organization running log)
 - (8) how well bottom plugged BWD

description of formations encountered	from	to
top soil	0	2
sandy clay	2	20
chalk	20	60
fine sand	60	100
sand & gravel	100	130


DRILLERS REMARKS:


RECEIVED
 AUG 21 1978

MISS. BD. OF WATER COMMISSIONERS

If well telescopes please sketch and show depths.

GROUND LEVEL

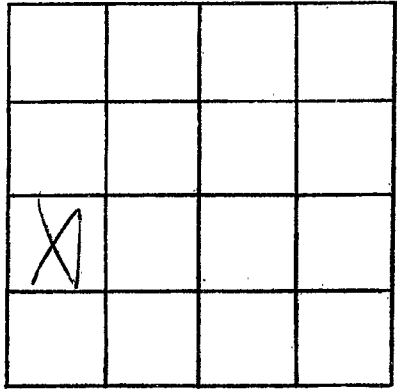

SECTION _____

Please indicate well location X.

ADDITIONAL INFORMATION

If more than one screen,
show locations of each on sketch.