

WALTHALL

E 2022

6-5-78

MISSISSIPPI BOARD OF WATER COMMISSIONERS 416 North State Street Jackson, Mississippi 39201

WATER WELL DRILLERS LOG

June 5 1978 Reems Well in Walthall date well completed firm name county well located

LANDOWNER:

Noah Stringer Jr. Rt 1 Tipton (mailing address)

description of formations encountered

from to

Red sandy clay 0 27 Red sand + gravel 27 70 tubular 70 96 Gravel sand 96 127

WELL LOCATION:

sec. 13 T 2 N R 10 E 7 7 miles ENE of Tipton (distance) (direction) (nearest town)

WELL PURPOSE: Reems (home, irrigation, municipal, industrial)

WELL COMPLETION DATA:

- (1) diameter (inches) 4" (2) total depth (feet) 127 (3) static water level (feet) 90 below top of ground. (4) casing plastic bottom (material) (depth) (size) If telescope see back. (5) screen 5' 122' (length) (depth to top) 4" plastic (size) (material) (6) pump 1/2 sub 10 (HP) (yield gpm) (type power) (7) electric log no (yes or no) (organization running log)

(8) how well bottom plugged was plug


DRILLERS REMARKS:

RECEIVED OCT 25 1978

MISS. BD. OF WATER COMMISSIONERS

If well telescopes please sketch and show depths.

GROUND LEVEL

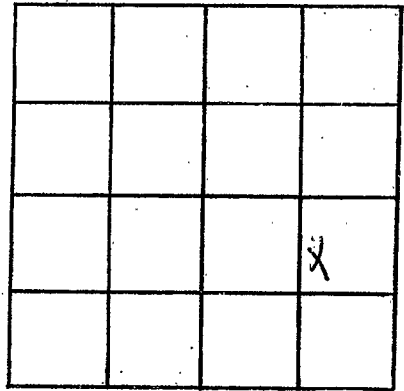

SECTION 13

Please indicate well location X.

ADDITIONAL INFORMATION

If more than one screen,
show locations of each on sketch.