

WALTHALL

E 2033

11-3-78

MISSISSIPPI BOARD OF WATER COMMISSIONERS 416 North State Street Jackson, Mississippi 39201

WATER WELL DRILLERS LOG

11-3 date well completed

19 78 Ft. Webb Driller firm name

Walthall county well located

LANDOWNER: Carol Smith RR telephone (mailing address)

Table with 3 columns: description of formations encountered, from, to. Rows include: Red clay (0-20), Red sand (20-90), gravel (90-125), White chalk (125-165), coarse sand & gravel (165-182)

WELL LOCATION: sec. 28 T 2 N R 10 E 3 miles WSW of Walthall (distance) (direction) (nearest town)

WELL PURPOSE: Home (home, irrigation, municipal, industrial)

- WELL COMPLETION DATA: (1) diameter (inches) 4 (2) total depth (feet) 180 (3) static water level (feet) 110 below above top of ground. (4) casing (material) PVC (depth) 172 (size) 4 if telescope see back. (5) screen (length) 8 (depth to top) 172 (size) 4 (material) PVC (6) pump (HP) 2 (yield. gpm) 25 (type power) electric (7) electric log (yes or no) no

(organization running log) (8) how well bottom plugged: Sand filled

DRILLERS REMARKS:


RECEIVED

DEC - 7 1978

MISS. Bd. OF WATER COMMISSIONERS

If well telescopes please sketch and show depths.

GROUND LEVEL

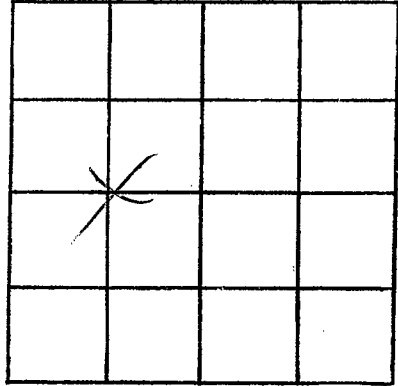

SECTION 28

Please indicate well location X.

ADDITIONAL INFORMATION

If more than one screen, show locations of each on sketch.