

WALTHALL

E

2034

12-22-78

MISSISSIPPI BOARD OF WATER COMMISSIONERS
416 North State Street
Jackson, Mississippi 39201

WATER WELL DRILLERS LOG

12-22-78
date well completed

1978 *Figueroa & Co Inc*
firm name

Walthall
county well located

LANDOWNER:
Van Estes
P.R. Fyfe
(mailing address)


description of formations encountered	from	to
<i>Red clay</i>	<i>0</i>	<i>20</i>
<i>white chalk</i>	<i>20</i>	<i>90</i>
<i>Fine sand</i>	<i>90</i>	<i>140</i>
<i>Coarse sand</i>	<i>140</i>	<i>150</i>

WELL LOCATION:
sec. 13 T 2 N R 10 E
S W
6 miles W of *Fyfe*
(distance) (direction) (nearest town)

WELL PURPOSE: *Home*
(home, irrigation, municipal, industrial)

- WELL COMPLETION DATA:
- (1) diameter (inches) 4
 - (2) total depth (feet) 150
 - (3) static water level (feet) 20 below top of ground.
 - (4) casing *20 c*, *142*,
(material) (depth)
4 if telescope see back.
(size)
 - (5) screen 8, 142
(length) (depth to top)
4, *20 c*
(size) (material)
 - (6) pump *1/2*, 10
(HP) (yield gpm)
4hp
(type power)
 - (7) electric log *no*
(yes or no)
(organization running log)
 - (8) how well bottom plugged *Sand Ark*

DRILLERS REMARKS:

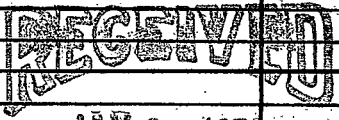

JAN 26 1979

