

WALTHAM
E 5530
7-15-78

MISSISSIPPI
BOARD OF WATER COMMISSIONERS
416 North State Street
Jackson, Mississippi 39201

WATER WELL DRILLERS LOG

7-15 1978 Fitzgibbon Well Serv Waltham
date well completed firm name county well located

LANDOWNER:	description of formations encountered	from	to
<u>O. C. Holliday</u>			
<u>RR. 4 location</u> (mailing address)	<u>Red clay</u>	<u>0</u>	<u>20</u>
	<u>Red sand & gravel</u>	<u>20</u>	<u>105</u>
	<u>Coarse sand & gravel</u>	<u>105</u>	<u>120</u>

WELL LOCATION:
sec. 23 T. 2 N R. 10 E
S W
2 miles W of Flycatcher
(distance) (direction) (nearest town)

WELL PURPOSE:
(home, irrigation, municipal, industrial) Water


- WELL COMPLETION DATA:
- (1) diameter (inches) 4
 - (2) total depth (feet) 120
 - (3) static water level (feet) 70 below above top of ground.
 - (4) casing PVC 112
(material) (depth)
4 if telescope see back.
(size)
 - (5) screen 8 112
(length) (depth to top)
4 PVC
(size) (material)
 - (6) pump 1/2 10
(HP) (yield gpm)
Electric
(type power)
 - (7) electric log no
(yes or no)
(organization running log)
 - (8) how well bottom plugged Small plug

DRILLERS REMARKS:

REGISTERED
AUG 14 1978
MISS. BD. OF WATER COMMISSIONERS

If well telescopes please sketch and show depths.

GROUND LEVEL

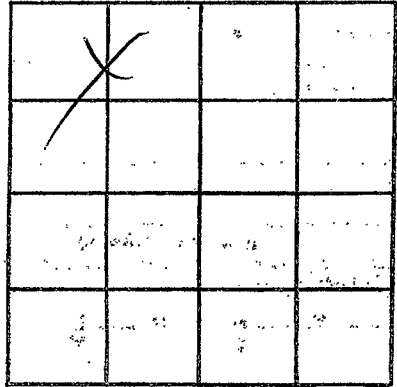

SECTION 23

Please indicate well location X.

ADDITIONAL INFORMATION

If more than one screen, show locations of each on sketch.