

*Walthall*  
*E0038*  
 5-2-79

MISSISSIPPI  
 BOARD OF WATER COMMISSIONERS  
 416 North State Street  
 Jackson, Mississippi 39201

WATER WELL DRILLERS LOG

May 2 1979 *Reeves-Walker Walthall*  
 date well completed firm name county well located

LANDOWNER:  
*Charles Shaffer*  
*Rt 3 Tyltown*  
 (mailing address)

description of formations encountered	from	to
<i>red clay</i>	<i>27</i>	<i>27</i>
<i>red sand</i>	<i>27</i>	<i>75</i>
<i>chalk &amp; lobby</i>	<i>75</i>	<i>112</i>
<i>gravel &amp; sand</i>	<i>112</i>	<i>128</i>

WELL LOCATION:  
 sec. *9* T. *2* N R. *9* E  
*4* miles *W. NW* of *Tyltown*  
 (distance) (direction) (nearest town)

WELL PURPOSE: *home*  
 (home, irrigation, municipal, industrial)

WELL COMPLETION DATA:

(1) diameter (inches) *4"*

(2) total depth (feet) *128*

(3) static water level (feet) *90* below top of ground.

(4) casing *plaster bottom*  
 (material) (depth)

*—* If telescope see back.  
 (size)

(5) screen *5'* *123'*  
 (length) (depth to top)

*4"* *plaster*  
 (size) (material)

(6) pump *1/2* *10*  
 (HP) (yield gpm)

*elect*  
 (type power)

(7) electric log *no*  
 (yes or no)

*—*  
 (organization running log)

(8) how well bottom plugged  
*wooden plug*

DRILLERS REMARKS:  
*—*


DEPT. OF NATURAL RESOURCES  
 BUREAU OF LAND & WATER CONSERVATION

OCT 19 1979

RECEIVED

If well telescopes please sketch and show depths.

GROUND LEVEL

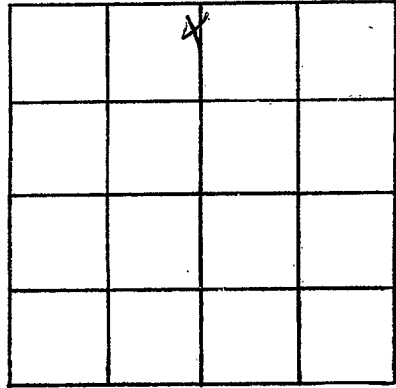

SECTION 9

Please indicate well location X.

ADDITIONAL INFORMATION

If more than one screen,  
show locations of each on sketch.