

WALTHAM

K 2039

Apr 5-79

Sept 5

MISSISSIPPI BOARD OF WATER COMMISSIONERS
416 North State Street
Jackson, Mississippi 39201

WATER WELL DRILLERS LOG

date well completed

firm name

county well located

1979 River Valley Waltham

LANDOWNER:	description of formations encountered	from	to
Willie Galbin	Clay	0	1'2
Rt 3 Tylertown	Red sand	12	5'5"
(mailing address)	Sand & gravel	55	76
WELL LOCATION:	blue clay	76	115
sec. 10 T 2 N R 10 E	fine sand	115	147
3 1/2 miles W-NW of Tylertown	Coarse sand	147	178
(distance) (direction) (nearest town)			
WELL PURPOSE: home			
(home, irrigation, municipal, industrial)			
WELL COMPLETION DATA:			
(1) diameter (inches) 4"			
(2) total depth (feet) 178			
(3) static water level (feet) 85 below top of ground.			
(4) casing plastic bottom (material) (depth)			
(size) If telescope see back.			
(5) screen 5' (length) 173' (depth to top)			
(size) (material) 4" plastic			
(6) pump 1/2 HP (HP) 10 (yield gpm)			
(type power) sheet			
(7) electric log no (yes or no)			
(organization running log)			
(8) how well bottom plugged			
wooden plug			
DRILLERS REMARKS:			


DEPT. OF NATURAL RESOURCES
BUREAU OF LAND & WATER RESOURCES

JUN 25 1980

RECEIVED

If well telescopes please sketch and show depths.

GROUND LEVEL

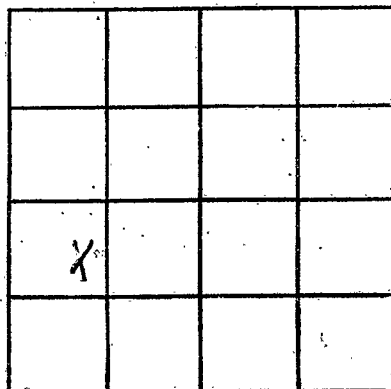

SECTION 10

Please indicate well location X.

ADDITIONAL INFORMATION

If more than one screen,
show locations of each on sketch.