

Walthall
ESD 41
8-16-79

MISSISSIPPI
 BOARD OF WATER COMMISSIONERS
 416 North State Street
 Jackson, Mississippi 39201

WATER WELL DRILLERS LOG

8-16
 date well completed

1979

Fitzell well
 firm name

walthall
 county well located

LANDOWNER:	description of formations encountered	from	to
<u>Bob Beaney -</u>			
<u>R.R. Lybster</u> (mailing address)	<u>Red clay</u>	<u>0</u>	<u>20</u>
	<u>Red sand</u>	<u>20</u>	<u>60</u>
	<u>Coarse sand & gravel</u>	<u>60</u>	<u>75</u>

LANDOWNER:

Bob Beaney -

R.R. Lybster
(mailing address)

WELL LOCATION:

sec. 34 T 2 N R 16 E
 S W
2 miles W of Lybster
 (distance) (direction) (nearest town)

WELL PURPOSE: 16
 (home, irrigation, municipal, industrial)

WELL COMPLETION DATA:

- (1) diameter (inches) 4
- (2) total depth (feet) 75
- (3) static water level (feet) 15 below top of ground.
- (4) casing 402 67
 (material) (depth)
4 if telescope see back.
 (size)
- (5) screen 8 67
 (length) (depth to top)
4 402
 (size) (material)
- (6) pump 1/2 10
 (HP) (yield gpm)
Elc
 (type power)
- (7) electric log
 (yes or no)
 (organization running log)
- (8) how well bottom plugged Sand Pak

Miss. Board of Water Comm.


SEP 12 1979

RECEIVED

DRILLERS REMARKS:

If well telescopes please sketch and show depths.

GROUND LEVEL

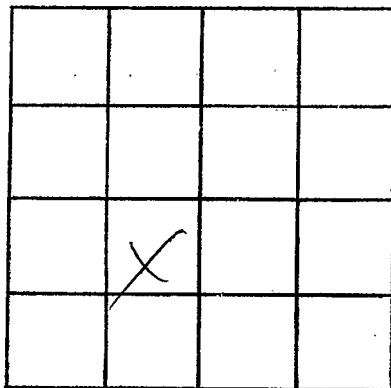

SECTION 24

Please indicate well location X.

ADDITIONAL INFORMATION

If more than one screen, show locations of each on sketch.