

Walthall  
E 2042  
5-21-79

MISSISSIPPI  
BOARD OF WATER COMMISSIONERS  
416 North State Street  
Jackson, Mississippi 39201

WATER WELL DRILLERS LOG

5-21 1979 Fitzgerald Well Service Walthall  
date well completed firm name county well located

LANDOWNER:	description of formations encountered	from	to
<u>Kerby Beitham</u>			
<u>R.R. Gleton</u> (mailing address)	<u>Red clay</u> <u>Red sand</u> <u>Coarse sand &amp; gravel</u>	<u>0</u> <u>20</u> <u>80</u>	<u>20</u> <u>80</u> <u>95</u>
<b>WELL LOCATION:</b>			
sec. <u>14</u> T <u>20</u> N R <u>10</u> E <u>2</u> miles <u>W</u> of <u>Gleton</u> (distance) (direction) (nearest town)			
<b>WELL PURPOSE:</b> <u>Home</u> (home, irrigation, municipal, industrial)			
<b>WELL COMPLETION DATA:</b>			
(1) diameter (inches) <u>4</u>			
(2) total depth (feet) <u>95</u>			
(3) static water level (feet) <u>45</u> below top of ground.			
(4) casing <u>PVC</u> , <u>87</u> , (material) (depth)			
<u>4</u> if telescope see back. (size)			
(5) screen <u>8</u> , <u>87</u> (length) (depth to top)			
<u>4</u> , <u>PVC</u> (size) (material)			
(6) pump <u>1/2</u> , <u>10</u> (HP) (yield gpm)			
<u>elec</u> (type power)			
(7) electric log <u>no</u> (yes or no)			
(organization running log)			
(8) how well bottom plugged <u>Sand shell</u>			
<b>DRILLERS REMARKS:</b>			


Miss. Board of Water Comm.

JUL 17 1979

RECEIVED

If well telescopes please sketch and show depths.

GROUND LEVEL

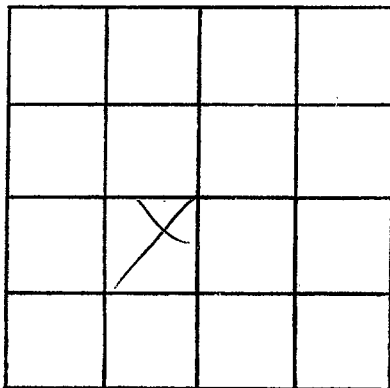

SECTION 14

Please indicate well location X.

ADDITIONAL INFORMATION

If more than one screen, show locations of each on sketch.