

Walthall
 E 2043
 May 7, 1979

MISSISSIPPI
 BOARD OF WATER COMMISSIONERS
 416 North State Street
 Jackson, Mississippi 39201

WATER WELL DRILLERS LOG

5-7 date well completed 19 79 firm name *Fitzmaurice Well Serv* county well located *Walthall*

LANDOWNER:
Chester Moore
R.R. 5 Gylston
 (mailing address)

description of formations encountered	from	to
<i>Red Clay</i>	<i>0</i>	<i>15</i>
<i>Red sand & clay</i>	<i>15</i>	<i>125</i>
<i>Coarse sand</i>	<i>125</i>	<i>135</i>

WELL LOCATION:
 sec. *24* T *2* N R *9* E
 S W
5 miles *W* of *Gylston*
 (distance) (direction) (nearest town)

WELL PURPOSE: *Home*
 (home, irrigation, municipal, industrial)

- WELL COMPLETION DATA:
- (1) diameter (inches) *4*
 - (2) total depth (feet) *135*
 - (3) static water level (feet) *4* ~~below~~ above top of ground.
 - (4) casing *PVC, 127,*
 (material) (depth)
4 if telescope see back.
 (size)
 - (5) screen *8, 127*
 (length) (depth to top)
4, PVC
 (size) (material)
 - (6) pump *1, 20*
 (HP) (yield gpm)
alt
 (type power)
 - (7) electric log *no*
 (yes or no)
 (organization running log)
 - (8) how well bottom plugged *Sand blk*

DRILLERS REMARKS:


Miss. Board of Water Comm.

JUL 17 1979

RECEIVED

If well telescopes please sketch and show depths.

GROUND LEVEL

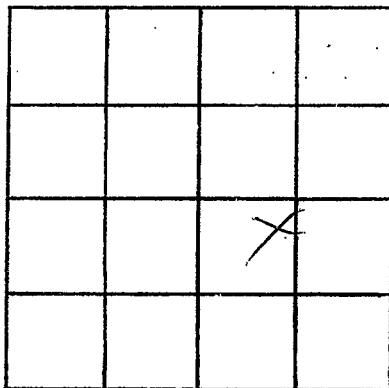

SECTION 24

Please indicate well location X.

ADDITIONAL INFORMATION

If more than one screen, show locations of each on sketch.