

Walthall
 E 2044
 May 8, 1979

MISSISSIPPI
 BOARD OF WATER COMMISSIONERS
 416 North State Street
 Jackson, Mississippi 39201

WATER WELL DRILLERS LOG

5-8 date well completed 1979 firm name Fiberglass Well Co. Walthall county well located

LANDOWNER:
 Okner Lemmons
 RR-5 Clinton
 (mailing address)

| description of formations encountered | from | to |
|---------------------------------------|------|-----|
| Red clay | 0 | 20 |
| Red sand & gravel | 20 | 120 |
| White Blue Chalk | 120 | 230 |
| Coarse sand & gravel | 230 | 241 |

WELL LOCATION:
 sec. 7 T 2 N R 10 E
 S W
 1 miles S of Kato
 (distance) (direction) (nearest town)

WELL PURPOSE: Home
 (home, irrigation, municipal, industrial)

- WELL COMPLETION DATA:
- (1) diameter (inches) 4
 - (2) total depth (feet) 241
 - (3) static water level (feet) 140 below above top of ground.
 - (4) casing PVC 233
 (material) (depth)
 4 if telescope see back.
 (size)
 - (5) screen 8 233
 (length) (depth to top)
 4 PVC
 (size) (material)
 - (6) pump 1/2 8
 (HP) (yield gpm)
 Elec
 (type power)
 - (7) electric log no
 (yes or no)
 (organization running log)
 - (8) how well bottom plugged Seal plug

DRILLERS REMARKS:


Miss. Board of Water Comm.

JUL 17 1979

RECEIVED

If well telescopes please sketch and show depths.

GROUND LEVEL

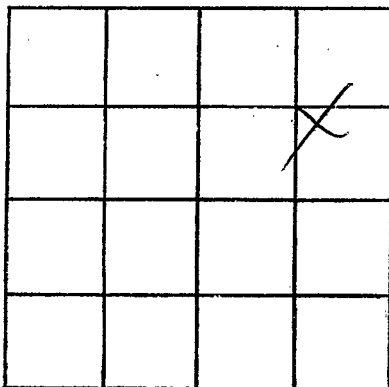

SECTION 7

Please indicate well location X.

ADDITIONAL INFORMATION

If more than one screen,
show locations of each on sketch.