

WALTHALL
 E 2045
 6-28-79

MISSISSIPPI
 BOARD OF WATER COMMISSIONERS
 416 North State Street
 Jackson, Mississippi 39201

WATER WELL DRILLERS LOG

6-28 19 79 Fitzgerald Well Service WALTHALL
 date well completed firm name county well located

LANDOWNER:
Dewey Martin
R.R. Tylertown
 (mailing address)

description of formations encountered	from	to
<u>Red clay</u>	<u>0</u>	<u>20</u>
<u>Red sand & gravel</u>	<u>20</u>	<u>100</u>
<u>Red sand</u>	<u>100</u>	<u>120</u>
<u>Gravel sand & gravel</u>	<u>120</u>	<u>133</u>

WELL LOCATION:
 sec. 22 T. 2 N R. 10 E
 S W
2 miles W of Tylertown
 (distance) (direction) (nearest town)

WELL PURPOSE: Home
 (home, irrigation, municipal, industrial)

WELL COMPLETION DATA:

(1) diameter (inches) 4

(2) total depth (feet) 133

(3) static water level (feet) 75 below above-top of ground.

(4) casing PVC, 125,
 (material) (depth)

4 if telescope see back.
 (size)

(5) screen 8, 125
 (length) (depth to top)

4, PVC
 (size) (material)

(6) pump 1/2, 10
 (HP) (yield gpm)

cl
 (type power)

(7) electric log no
 (yes or no)

(organization running log)

(8) how well bottom plugged sand blk

DRILLERS REMARKS:


Miss. Board of Water Comm.

AUG 3 1979

RECEIVED

If well telescopes please sketch and show depths.

GROUND LEVEL

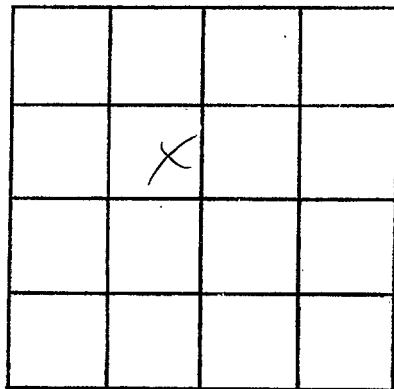

SECTION 22

Please indicate well location X.

ADDITIONAL INFORMATION

If more than one screen,
show locations of each on sketch.