

WALTHALL

E 2048

6-29-79

MISSISSIPPI BOARD OF WATER COMMISSIONERS
416 North State Street
Jackson, Mississippi 39201

WATER WELL DRILLERS LOG

6-29 1979
date well completed

Fitzgerald Well Service
firm name

Walthall
county well located

LANDOWNER:

David Fails

R.R. Fyfe
(mailing address)

description of formations encountered

from

to

Red clay	0	20
Coarse sandstone	20	50
with chert	50	120
Coarse sandstone	120	138

WELL LOCATION:

sec. 19 T 2 N R 10 E
S W
5 miles W of Fyfe
(distance) (direction) (nearest town)

WELL PURPOSE: Home
(home, irrigation, municipal, industrial)

WELL COMPLETION DATA:

- (1) diameter (inches) 4
- (2) total depth (feet) 138
- (3) static water level (feet) 6 below top of ground.
- (4) casing PVC, 130, (material) (depth)
4 (size) if telescope see back.
- (5) screen 8, 130 (length) (depth to top)
4, PVC (size) (material)
- (6) pump 1/2, 10 (HP) (yield gpm)
Elec (type power)
- (7) electric log no (yes or no)
(organization running log)
- (8) how well bottom plugged sand blk

Miss. Board of Water Comm.


AUG 3 1979

RECEIVED

DRILLERS REMARKS:

If well telescopes please sketch and show depths.

GROUND LEVEL

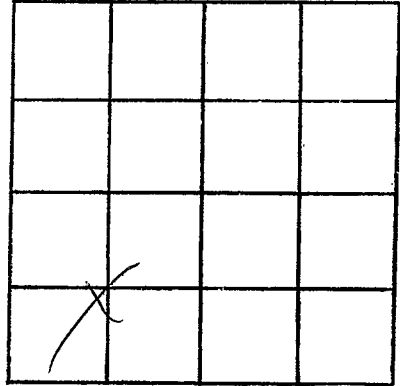

SECTION 19

Please indicate well location X.

ADDITIONAL INFORMATION

If more than one screen,
show locations of each on sketch.