

WALTHALL

E 2049

9-29-80

MISSISSIPPI
 BOARD OF WATER COMMISSIONERS
 416 North State Street
 Jackson, Mississippi 39201

WATER WELL DRILLERS LOG

9-29 1980
date well completed

Fitzgerald Well Serv
firm name

Walthall
county well located

LANDOWNER:

David Popwell

R.R. Fultown
(mailing address)

description of formations encountered

from to

Red clay	0	20
Red sand	20	90
Coarse sand & gravel	90	108

WELL LOCATION:

sec. 23 T 2 N R 10 E
 S
 2 miles W of Fultown
 (distance) (direction) (nearest town)

WELL PURPOSE:

Home
(home, irrigation, municipal, industrial)

WELL COMPLETION DATA:

- (1) diameter (inches) 4
- (2) total depth (feet) 108
- (3) static water level (feet) 6 below top of ground.
- (4) casing PVC, 100 (depth), 4 (size) If telescope see back.
- (5) screen 8 (length), 100 (depth to top), 4 (size), PVC (material)
- (6) pump 1/2 (HP), 10 (yield gpm), Elm (type power)
- (7) electric log no (yes or no)
(organization running log)
- (8) how well bottom plugged sand shk

DRILLERS REMARKS:


DEPT. OF NATURAL RESOURCES
 BUREAU OF LAND & WATER RESOURCES

DEC - 9 1980

RECEIVED

If well telescopes please sketch and show depths.

GROUND LEVEL

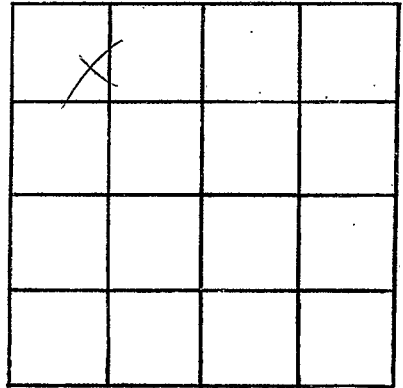

SECTION 23

Please indicate well location X.

ADDITIONAL INFORMATION

If more than one screen,
show locations of each on sketch.